

\$ 4.00 REMONUMENTATION

\$ 10.00 DEED

26-DEC 95 3:25 P.M. RECEIVED A

LAND CORNER RECORDATION CERTIFICATE

Filing Requirement of Act 74, Mich., P.A. 1970

RECORDED
FOREST E. YOUNGBLOOD, REGISTER OF DEEDS
WAYNE COUNTY, MI

SEQUENCE # 2

Compliance with
ACT 345, P.A. 1990

APPROVED ON: 12-13-95
WAYNE COUNTY REMONUMENTATION
PEER GROUP COMMITTEE

Register of Deeds Stamp & File Number

LIBER 28482 PAGE 694

For corners in

WAYNE

(County)

Located In:
PLYMOUTH TWP

Corner Code #

1. Public Land Survey	T	<u>1 S</u>	<u>R 8 E</u>	<u>E-7</u>
	T		R	
	T		R	
	T		R	
2. Property controlling in Section	S	T	R	<u>SURVEY &</u>
	S	T	R	<u>REMONUMENTATION</u>
3. Miscellaneous Property in Sec.	S	T	R	
	S	T	R	

APR 05 1996

COMMISSION


4. Lot No. _____, Recorded Plat _____
5. Private Claims _____

I, PAUL V. SCHWIMMER, in a field survey on NOVEMBER 13, 19 95 do hereby certify that under requirements of P.A. 74, Michigan P.A. of 1970, the corner points mentioned in lines 1 and 2 above were in conformance with regulations and rules therefore as required in the current manual of survey instructions of the United States Department of the Interior, Bureau of Land Management or by decree of a Court of Law and/or that the corner points mentioned in lines 3, 4 and 5 above were in conformance with the rules of the Michigan Board of Land Surveyors or by Decree of a Court of Law; established, re-established, monumented, re-monumented, recovered, found as expressed below:

NOTE: Not more than 4 corners, all in the same town and range, may be recorded on this certificate

A. Description of original monument and accessories and/or subsequent restoration:


ORIG. GOVERNMENT NOTES 1815, WITNESSED BY BALESS JIMMINGS - SET POST (1)	BOARD OF WAYNE CO. RD. COMM MON. IN BOX FOUND IN 1970 (10)
ELM 14° S17°W 6 LINKS (2)	N.E. 47.17 DE POLE (11)
IRONWOOD 4° N62°E 13 LINKS (3)	S.E. 57.16 MBT POLE (12)
WAYNE CO. BUREAU OF TAXATION (1930'S) IRON (4)	S.W. 63.40 MBT. POLE (13)
N.E. 48.77 IRON (5)	N.W. 79.28 CENTER PBM #20-30 (14)
S.E. 37.42 SIGN POST (6)	
S.E. 1.50 CROSS IN PAVEMENT (7)	
S.W. 46.80 IRON (8)	
N.W. 68.40 IRON (9)	

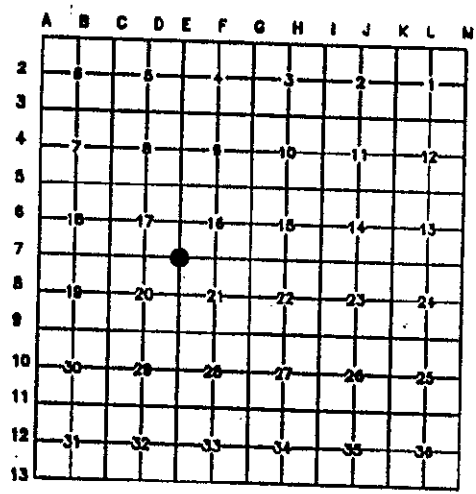

95274746

CONTINUED ON BACK

B. Description of corner evidence and/or method applied in restoring or reestablishing corner:
E-7 THIS CORNER TRACKS VERY WELL FROM 1970 TO PRESENT. WE VERIFIED DISTANCE CHECKS TO D-7 AND E-6 TO TIE IT INTO THE 1930 RESURVEY INFORMATION AND HAVE ACCEPTED IT AS THE CORRECT LOCATION OF THIS CORNER

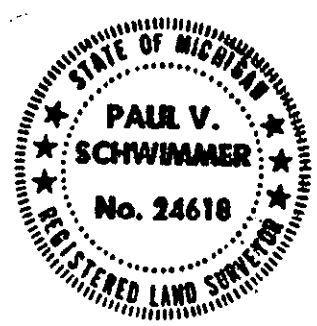

C. Description of monument for corner and accessories established to perpetuate locating the position of the corner:
E-7 FOUND BROKEN CONC. MONUMENT W/ 1/2" ROD IN MONUMENT BOX. TOP OF ROD IS 0.15' BELOW TOP OF BOX REPLACED WITH NEW 1/2" IRON ROD IN NEW MONUMENT BOX

N50°E 72.41 NAIL W/ W.C.R.C. TAG IN POWER POLE	WAYNE CO. REMONUMENTATION DISKS WERE PLACED ON THE IRON MARKER.
N70°E 121.31 TOP SPINDLE OF HYDRANT	
S45°E 88.73 TOP SPINDLE OF HYDRANT	
S55°E 74.39 C/L OF WATER GATE VALVE (17)	
S35°E 63.62 NAIL W/ W.C.R.C. TAG IN POWER POLE	
S55°W 87.07 NAIL W/ W.C.R.C. TAG IN POWER POLE	
S50°W 80.21 C/L OF WATER GATE VALVE (18)	
N60°W 76.47 NAIL W/ W.C.R.C. TAG IN POWER POLE	

DIST TO D-7 MEAS @ 2638.58 AND RECORDED IN THE 1930 RESURVEY EFFORT AS 2638.47
DIST TO E-6 MEAS @ 2565.59 AND RECORDED IN THE 1930 RESURVEY EFFORT AS 2566.45
THE SELECTED LOCATION IS ACCEPTED BY THE CONTRACTOR AND IS GENERALLY ACCEPTED BY PROFESSIONAL SURVEYORS AS THE BEST AVAILABLE EVIDENCE OF THE POSITION OF THE ORIGINAL CORNER.

Signed by Paul V. Schwimmer
Surveyor's Michigan License No. 24618

Date 12-15-95

112