

FILE DO NOT MAIL

RE...

FEB 28 2000

LAND CORNER RECORDATION CERTIFICATE
Filing Requirement of Act 74, Mich. P.A. 1970

SECTION

For corners in

WAYNE (County) Located In: CITY OF LIVONIA (COMMON CORNER WITH M-10) Corner Code #
1. Public Land Survey T R
2. Property Controlling in Section S T 1S R 9E A-10
3. Miscellaneous Property in Sec. S T R
4. Lot No. Recorded Plat
5. Private Claims

Liber-30814 Page-5
99586943 12/21/1999
F.E. Youngblood, Wayne Co. Register of Deeds
Compliance with ACT 345, P.A. 1990
APPROVED ON: 12-8-99
WAYNE COUNTY REMONUMENTATION PEER GROUP COMMITTEE
Register of Deeds Stamp & File Number

I, PAUL V. SCHWIMMER, in a field survey on NOV 01, 19 99 do hereby state that under requirements of P.A. 74, Michigan P.A. of 1970, the corner points mentioned in lines 1 and 2 above were in conformance with regulations and rules therefore as required in the current manual of survey instructions of the United States Department of the Interior, Bureau of Land Management or by a decree of a Court of Law and/or that the corner points mentioned in lines 3, 4 and 5 above were in conformance with the rules of the Michigan Board of Land Surveyors or by a Decree of a Court of Law; established, re-established, monumented, recovered, found as expressed below:

NOTE: Not more than 2 corners, all in the same town and range, may be recorded on this certificate.

NOTE: NUMBERS IN (*) ARE USED TO TRACE THE CHAIN OF EVENTS AS RECORDED BY PREVIOUS SURVEYORS WITNESSES

Grid table with columns A-M and rows 1-13. Cell 10,1 contains a dot.

A. Description of original monument and accessories and/or subsequent restoration:


GOVERNMENT LAND OFFICE (1816) NOTE: THE WEST 1/4 CORNER (A-10) WAS NOT SET DURING THE ORIGINAL SURVEYS
1930'S WAYNE COUNTY RESURVEY EFFORT SHOWS THE POSITION OF A-10 TO BE COMMON WITH M-10 OF T1S, R8E
1930'S WAYNE COUNTY BUREAU OF TAXATION WITNESSES; MONUMENT BOX (1) N.E. 67.30 24" OAK (2) (GONE) S.E. 45.25 5" OAK (3) (GONE) WEST 57.23 EDISON POLE (4) (GONE) N.W. 76.23 8" HICKORY (5) (GONE) (ALL OF THESE WITNESSES HAVE BEEN REMOVED BY THE WIDENING OF ECKLES ROAD)

(CONTINUED ON BACK)

B. Description of corner evidence found and/or method applied in restoring or reestablishing corner:

THIS POSITION WAS NOT SET IN THE ORIGINAL GOVERNMENT LAND SURVEYS. IT WAS SET BY SOMEONE PRIOR TO THE 1930'S WAYNE COUNTY RESURVEY EFFORT. ALL OF ANY PREVIOUS WITNESSES HAVE BEEN DESTROYED BY THE RECONSTRUCTION AND WIDENING OF ECKLES ROAD. OUR BEST EVIDENCE TO ITS ORIGINALLY SET POSITION IS BY MATCHING DISTANCES AND ANGLES AS RECORDED IN THE 1930'S SURVEY EFFORT.

- * A-10 TO A-9; 2639.58' RECORDED VERSUS 2639.70 MEASURED
* A-10 TO B-10: 2575.06 RECORDED VERSUS 2575.16 MEASURED
* THE ANGLE OF A-9 - A-10 - B-10 IS 90°01'17" MEASURED VERSUS 90°02'50" RECORDED

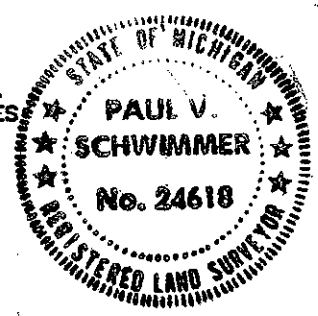

C. Description of monument for corner and accessories established to perpetuate locating the position of the corner:

A-10 RECOVERED A 3/4" IRON PIPE (6) 1.1 FEET BELOW ROAD SURFACE IN A MONUMENT BOX. THE POSITION OF THIS CORNER WAS VERIFIED BY MATCHING MEASURED DISTANCES AND ANGLES AGAINST RECORDED INFORMATION. THE ROAD SURFACE IS ASPHALT.
N 38° E 62.75 CENTER OF GATE VALVE
S 60° E 60.65 "X" IN N.W. BOLT OF LIGHT POLE BASE
S 20° W 139.15 SET NAIL AND REMONUMENTATION TAG IN WEST SIDE OF 14" MAPLE
S 56° W 42.45 CENTER OF SIGN POST
N 27° W 88.94 TOP CENTER OF HYDRANT
THE SELECTED LOCATION IS ACCEPTED BY THE CONTRACTOR AND IS GENERALLY ACCEPTED BY PROFESSIONAL SURVEYORS AS THE BEST AVAILABLE EVIDENCE OF THE POSITION OF THE ORIGINAL CORNER. THIS IS A COMMON CORNER WITH M-10, PLYMOUTH TWP.

Signed by Paul V. Schwimmer
Surveyor's Michigan License No. 24618

Date 12-15-1999

R LCR 12 4R 2 Pgs A. DPJ

SURVEY &
RECORDS SECTION

FEB 28 2000

SECTION

SECTION "A" CONTINUED

SECOND SET OF 1930 WAYNE COUNTY BUREAU OF TAXATION WITNESSES
WITH NO DATE BUT SET IN THE SAME FORMAT AS BEFORE:

IRON (6)

N.E.	67.30	24" OAK (2) (GONE)
N.E.	44.67	N.W. CORNER OF APRON (7) (GONE)
S.E.	44.30	S.W. CORNER OF APRON (8) (GONE)
S.E.	45.25	8" OAK (3) (GONE)
WEST	20"	EDGE OF PAVEMENT (9) (GONE)
N.E.	65.75	"X" IN RIM OF MANHOLE COVER (10) (GONE)

A-10 IS IMPLIED ON THE RECORDED PLAT OF "TWIN ARBORS SUBDIVISION"
(LIBER 88, PAGE 84 & 85, WAYNE COUNTY RECORDS)