

LAND CORNER RECORDATION CERTIFICATE  
 Filing Requirement of Act 74, Mich. P.A. 1970

\$ 4.00 REMONUMENTATION  
 \$0.00 DEED  
 DEC 96 11:12 A.M. RECEI  
 RECORDED  
 FOREST E. YOUNGBLOOD, REGISTER  
 WAYNE COUNTY, MI EDS

For corners in

WAYNE (County)	Located In: CITY OF LIVONIA	Corner Code #
1. Public Land Survey	T 1S R 9E	D-11
	T R	
	T R	
	T R	
2. Property Controlling in Section	S T R	
	S T R	
3. Miscellaneous Property in Sec.	S T R	
	S T R	

Compliance with  
 ACT 345, P.A. 1990  
 APPROVED ON: 12-16-1996  
 WAYNE COUNTY REMONUMENTATION  
 PEER GROUP COMMITTEE  
 Register of Deeds Stamp & File Number

4. Lot No. \_\_\_\_\_, Recorded Plat \_\_\_\_\_  
 5. Private Claims \_\_\_\_\_

I, PAUL V. SCHWIMMER, in a field survey on NOV 11, 1996 do hereby state that under requirements of P.A. 74, Michigan P.A. of 1970, the corner points mentioned in lines 1 and 2 above were in conformance with regulations and rules therefore as required in the current manual of survey instructions of the United States Department of the Interior, Bureau of Land Management or by a decree of a Court of Law and/or that the corner points mentioned in lines 3, 4 and 5 above were in conformance with the rules of the Michigan Board of Land Surveyors or by a Decree of a Court of Law; established, re-established, monumented, recovered, found as expressed below:

	A	B	C	D	E	F	G	H	I	J	K	L
1												
2	6		5		4		3		2		1	
3												
4	7		8		9		10		11		12	
5												
6	18		17		16		15		14		13	
7												
8	19		20		21		22		23		24	
9												
10	30		29		28		27		26		25	
11												
12	31		32		33		34		35		36	
13												


NOTE: Not more than 2 corners, all in the same town and range, may be recorded on this certificate.

A. Description of original monument and accessories and/or subsequent restoration:

- G.L.D. (1816) POST AT AVERAGE DIST OF 40.10 CHAINS  
 W. OAK 16' N 73°E 11 LINKS (GONE)  
 W. OAK 10' N 63°W 34 LINKS (GONE)
- 1930'S BUREAU OF TAXATION - FOUND IRON  
 NNW 36.87' EDISON POLE (GONE) SW 51.33' EDISON POLE (GONE)  
 NE 100.47' TELE POLE (GONE) SE 46.30' EDISON GUY POLE (GONE)
- 1938 - SHOWN ON PLAT OF 'PLYMOUTH RIVERSIDE ESTATES', LI. 66, PG 69  
 (CONTINUED ON BACK)

B. Description of corner evidence found and/or method applied in restoring or reestablishing corner:

FOUND THE 3/4" IRON IN MONUMENT BOX AT THE INTERSECTION OF PLYMOUTH ROAD AND LEVAN ROAD. I COULD NOT FIND THE P.K. NAILS IN D.E. POLES (1981) AS DESCRIBED IN R.C. 787 BUT THE DISTANCES MATCHED FAIRLY WELL TO THE S.W. AND N.E. I ALSO CHECKED THE DISTANCES TO D-10 AND E-11 AGAINST DISTANCES MEASURED BY WPA SURVEY OF THE 1930'S AS FOLLOWS:  
 3/4" IRON IN HANDHOLE (FOUND)  
 S 27° W 71.6 P.K. NAIL NORTH FACE OF D.E. POLE (72.33 MEAS)  
 N 47° E 79.1 P.K. NAIL WEST FACE OF D.E. POLE (79.49 MEAS)  
 D-11 TO D-10 N 00°03'43" W 2642.45' (COMPUTED) 2643.24' (MEASURED)  
 D-11 TO E-11 N 89°59'30" E 2647.06' (RECORD) 2647.27' (MEASURED)  
 E-11

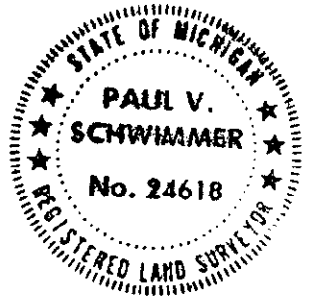

C. Description of monument for corner and accessories established to perpetuate locating the position of the corner:

- SET STANDARD BRASS DISC AND CAP No. 24618 ON FOUND 3/4" IRON IN MONUMENT BOX
  - N 48° E 79.49 SET NAIL AND 'WCR WITNESS' TAG IN S.E. SIDE OF WOOD LIGHTPOLE
  - N 65° E 112.33 TOP NUT OF HYDRANT
  - S 32° E 60.76 SET NAIL AND 'WCR WITNESS' TAG IN N.E. SIDE OF WOOD TRAFFIC SIGNAL POLE
  - S 21° E 64.97 TOP NUT OF HYDRANT
  - S 27° W 72.33 SET NAIL AND 'WCR WITNESS' TAG IN S.E. SIDE OF UTILITY POLE
  - S 35° W 69.31 CENTER OF CAST IRON COVER OF WAYNE COUNTY PRECISE BENCHMARK
  - N 33° W 77.31 NAIL AND 'WCR WITNESS' TAG IN S.W. SIDE OF UTILITY POLE
- THE SELECTED LOCATION AS ACCEPTED BY THE CONTRACTOR AND IS GENERALLY ACCEPTED BY THE PROFESSIONAL SURVEYORS AS THE BEST AVAILABLE EVIDENCE OF THE ORIGINAL CORNER

Signed by Paul V. Schwimmer  
 Surveyor's Michigan License No. 24618

Date 11-23-1996 4R  
 10D  
 J.P.J.

SECTION A (CON'T)

RECORDATION CERTIFICATE 787, RECORDED IN LIBER 21311, PG 89 (1981)

FOUND 3/4" IRON IN HANDHOLE (FOUND)

S 27° W 71.6 P.K. NAIL NORTH FACE OF D.E. POLE (72.33 MEAS)

N 37° W 69.6 P.K. NAIL N.E. FACE OF D.E. POLE (GONE)

N 47° E 79.1 P.K. NAIL WEST FACE OF D.E. POLE (79.49 MEAS)

1989 - SHOWN ON PLAT OF 'LEVAN COURT SUBDIVISION'

FILE DO NOT REMOVE