

APR 05 1996

COMMISSION

LAND CORNER RECORDATION CERTIFICATE
 Filing requirement of Act 74, Mich. P.A. 1970

\$ 4.00 REMONUMENTATION
 \$ 7.00 DEED

15 DEC 95 11:21 A.M. RECEI
 RECORDED
 FOREST E. YOUNGBLOOD, REGISTER
 WAYNE COUNTY, MI EDS

For corners in
WAYNE COUNTY Located In: LIVONIA Corner Code #
 (County)

1. Public Land Survey	T	<u>1 S</u>	R	<u>9 E</u>	<u>D - 13</u>
	T	_____	R	_____	_____
	T	_____	R	_____	_____
2. Property Controlling in Section	S	_____	T	_____	_____
	S	_____	T	_____	_____
3. Miscellaneous Property in Sec.	S	_____	T	_____	_____
	S	_____	T	_____	_____

LIBER 28465 PAGE 788

Compliance with
 ACT 345, P.A. 1990

APPROVED ON: 12-13-95
 WAYNE COUNTY REMONUMENTATION
 PEER GROUP COMMITTEE

Register of Deeds Stamp & File Number

35268804

4. Lot No. _____, Recorded Plat _____
 5. Private Claims _____

I, ROBERT J. SMALLEY, in a field survey on MARCH 23, 19 95, do hereby certify that under requirements of P.A. 74, Michigan P.A. of 1970, the corner points mentioned in lines 1 and 2 above were in conformance with regulations and rules therefore as required in the current manual of survey instructions of the United States Department of the Interior, Bureau of Land Management or by a decree of a Court of Law and/or that the cornerpoints mentioned in lines 3, 4 and 5 above were in conformance with the rules of the Michigan Board of Land Surveyors or by a Decree of a Court of Law; re-established, monumented, re-monumented, recovered, found as expressed below:

NOTE: Not more than 4 corners, all in the same town and range, may be recorded on this certificate.

	A	B	C	D	E	F	G	H	I	J	K	L	M
1													
2	6	5	4	3	2	1							
3													
4	7	8	9	10	11	12							
5													
6	18	17	16	15	14	13							
7													
8	19	20	21	22	23	24							
9													
10	30	29	28	27	26	25							
11													
12	31	32	33	34	35	36							
13													

A. Description of original monument and accessories and/or subsequent restoration:

GLO (1816): "POST"
 WPA SURVEY (1930'S) "FOUND IRON & REPLACED WITH MONUMENT"

B. Description of corner evidence found and/or method applied in restoring or reestablishing corner:

FOUND CONCRETE MONUMENT IN MONUMENT BOX IN JOY ROAD (ASPHALT PAVEMENT) . CHECKED DISTANCE TO C-13, E-13 AND WITNESS MONUMENTS AGAINST DISTANCES MEASURED BY WPA SURVEY AS FOLLOWS:

C-13 to D-13 -	N 87°50'10" W, 2558.10'(CALC.)	(MEAS. 2558.58')
D-13 to E-13 -	N 87°50'10" W, 2650.07'(CALC.)	(MEAS. 2650.63')
D-13 to D-1 (WESTLAND)	EAST 74.92'	(MEAS. 75.08')
D-13 to WITNESS -	NORTH 33.00'	(MEAS. 32.92')
D-13 to WITNESS -	N 45° E 46.67'	(MEAS. 46.62')

NOTE: THIS CORNER IS NOT COMMON WITH CORNER D-1 OF WESTLAND, T. 2 S., R. 9 E.


C. Description of monument for corner and accessories to perpetuate locating the position of the corner:

FOUND CONCRETE MONUMENT IN MONUMENT BOX IN JOY ROAD (ASPHALT PAVEMENT) ; SET "WAYNE COUNTY REMONUMENTATION" TAG & SURVEY CAP NO. "30086-26467" OVER IRON BAR IN MONUMENT

- NORTH 32.92'; FOUND CONCRETE MONUMENT.
- N. 45° E. 46.62'; FOUND CONCRETE MONUMENT.
- N. 64° E. 76.25'; FOUND NAIL IN WEST FACE OF 8" OAK TREE.
- EAST 75.08'; FOUND CONCRETE MONUMENT IN MONUMENT BOX AT D-1 (WESTLAND).
- S. 46° E. 37.96'; FOUND PK NAIL & "GW 81540" TAG.

THE SELECTED LOCATION IS ACCEPTED BY THE CONTRACTOR AND IS GENERALLY ACCEPTED BY PROFESSIONAL SURVEYORS AS THE BEST AVAILABLE EVIDENCE OF THE ORIGINAL CORNER

Signed by Robert J. Smalley Date Dec 13, 1995
 ROBERT J. SMALLEY
 Surveyor's Michigan License No. 26467

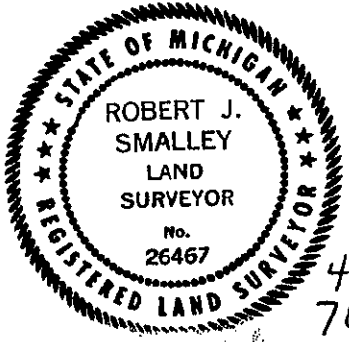

42
70