

FILE DO NOT MAIL

LAND CORNER RECORDATION CERTIFICATE
Filing Requirement of Act 74, Mich. P.A. 1970

FEB 28 2000

SECTION

For corners in

<u>WAYNE</u> (County)	Located in:	Corner Code #
	CITY OF LIVONIA	
1. Public Land Survey	T 1S R 9E	G-7
	T _____ R _____	_____
	T _____ R _____	_____
	T _____ R _____	_____
2. Property Controlling in Section	S _____ T _____ R _____	_____
	S _____ T _____ R _____	_____
3. Miscellaneous Property in Sec.	S _____ T _____ R _____	_____
	S _____ T _____ R _____	_____

Liber-30814 Page-3
 99586938 12/21/1999
 F.E. Youngblood, Wayne Co. Register of Deeds
 RDANDSYL

Compliance with
 ACT 345, P.A. 1990
 APPROVED ON: 12-8-99
 WAYNE COUNTY REMONUMENTATION
 PEER GROUP COMMITTEE
 Register of Deeds Stamp & File Number

4. Lot No. _____, Recorded Plat _____
 5. Private Claims _____

I, PAUL V. SCHWIMMER in a field survey on NOV 01, 19 99 do hereby state that under requirements of P.A. 74, Michigan P.A. of 1970, the corner points mentioned in lines 1 and 2 above were in conformance with regulations and rules therefore as required in the current manual of survey instructions of the United States Department of the Interior, Bureau of Land Management or by a decree of a Court of Law and /or that the corner points mentioned in lines 3, 4 and 5 above were in conformance with the rules of the Michigan Board of Land Surveyors or by a Decree of a Court of Law; established, re-established, monumented, recovered, found as expressed below.

NOTE: Not more than 2 corners, all in the same town and range, may be recorded on this certificate.

NOTE: NUMBERS IN (*) ARE USED TO TRACE THE CHAIN OF EVENTS AS RECORDED BY PREVIOUS SURVEYORS WITNESSES

A	B	C	D	E	F	G	H	I	J	K	L	M
1												
2	6	5	4	3	2	1						
3												
4	7	8	9	10	11	12						
5												
6	18	17	16	15	14	13						
7												
8	19	20	21	22	23	24						
9												
10	30	29	28	27	26	25						
11												
12	31	32	33	34	35	36						
13												

A. Description of original monument and accessories and/or subsequent restoration:

GOVERNMENT LAND OFFICE (1816) SET POST W. OAK 20° S 28° W .23 CHAINS (1) (GONE) W. OAK 12° N 26° E .30 CHAINS (2) (GONE)	1930'S WAYNE COUNTY BUREAU OF TAXATION WITNESSES; CROSS SET (3) (GONE) N.E. 71.00 32" MAPLE (4) (GONE) S.E. 63.68 EDISON POLE (5) (GONE) S.LY 62.40 HYDRANT (6) (GONE) S.W. 94.83 GAS PUMP BASE (7) (GONE) N.W. 97.46 GAS PUMP BASE (8) (GONE)
--	--

(CONTINUED ON BACK)

B. Description of corner evidence found and/or method applied in restoring or reestablishing corner:

WE RECOVERED A 4" CONCRETE MONUMENT WITH A 3/4" IRON PIPE IN A MONUMENT BOX. WE VERIFIED THIS POSITION BY THE COMPARISON OF THE 1930 REMONUMENTATION EFFORT TO 1999 FIELD MEASUREMENTS. WE ALSO USED EXISTING WITNESSES FROM A PREVIOUSLY RECORDED SURVEYOR McMAON ACT 74.

- * F-7 TO G-7: 2659.08' MEASURED VERSUS 2659.44 RECORDED
- * G-8 TO G-7: 2640.88 MEASURED VERSUS 2640.98 RECORDED
- * THE ANGLE OF F-7 - G-7 - G-8 IS 90°31'15" MEASURED VERSUS 90°32'20" RECORDED


C. Description of monument for corner and accessories established to perpetuate locating the position of the corner:

G-7 FOUND 4" CONCRETE MONUMENT WITH 3/4" IRON PIPE IN A MONUMENT BOX. THE MONUMENT BOX IS SET IN A CONCRETE ISLAND AT THE INTERSECTION OF FIVE MILE ROAD AND FARMINGTON ROAD PLACED REMON BRASS WASHOR OVER PIPE
 NORTH 49.89' FACE OF EXISTING LIGHT POLE (12) (50.00 RECORDED) LIC # 24618
 S 75°E 78.43' CENTER OF LIGHT POLE
 SOUTH 94.50' CENTER OF LIGHT POLE
 S 75°W 77.73' CENTER OF LIGHTPOLE
 S 30°E 45.35' CENTER OF MANHOLE (13) (R&M)
 S 35°W 24.40' CENTER OF MANHOLE (14) (R&M)

THE SELECTED LOCATION IS ACCEPTED BY THE CONTRACTOR AND IS GENERALLY ACCEPTED BY PROFESSIONAL SURVEYORS AS THE BEST AVAILABLE EVIDENCE OF THE POSITION OF THE ORIGINAL CORNER.

Signed by Paul V. Schwimmer
 Surveyor's Michigan License No. 24618

Date Nov 19 1999

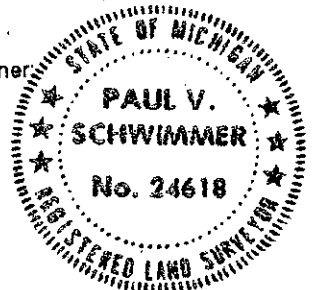

R LCR 12 4R 2 Pgs A. [Signature]

SECTION "A" CONTINUED

RECEIVED &
FEB 28 2000

SECOND SET OF 1930 WAYNE COUNTY BUREAU OF TAXATION WITNESSES
WITH NO DATE BUT SET IN THE SAME FORMAT AS BEFORE:

MONUMENT BOX (9)

N.E. 43.34 30° MAPLE (10) (GONE)

N.E. 71.00 30° MAPLE (4) (GONE)

S.E. 62.73 EDISON POLE (5) (GONE)

S.L.Y. 62.40 HYDRANT (6) (GONE)

RECORDED ACT 74 BY SURVEYOR JOHN J. McMAHON 1977 (RC 549)

FOUND HANDHOLE (11)

NORTH 50.00 FACE OF LIGHT POLE (12)

S 30°E 45.35 CENTER OF MANHOLE (13)

S 35°W 24.40 CENTER OF MANHOLE (14)

G-7 IS SHOWN ON THE PLAT OF "COVENTRY GARDENS" AS RECORDED IN LIBER 55 OF PLATS,
PAGES 34 & 35, WAYNE COUNTY RECORDS (1925)

G-7 IS IMPLIED ON THE PLAT OF "BRIGHTMOOR HOME ACRES" AS RECORDED
IN LIBER 51 OF PLATS, PAGE 1, WAYNE COUNTY RECORDS (1924)

SECTION