

SURVEY & REMONUMENTATION

APR 05 1996

LAND CORNER RECORDATION CERTIFICATE

Filing requirement of Act 74, Mich. P.A. 1970

\$ 4.00 REMONUMENTATION

\$ 7.00 DEED

15 DEC 95 11:21 A.M.

RECEIVED

RECORDED

E. YOUNGBLOOD, REGISTER
WAYNE COUNTY, MI

EDS

LIBER 28465 PAGE 790

COMMISSION
For corners in
WAYNE COUNTY
(County)

Located In: **LIVONIA** Corner Code #

1. Public Land Survey	T	<u>1 S</u>	R	<u>9 E</u>	<u>G - 13</u>
	T		R		
	T		R		
	T		R		
2. Property Controlling in Section	S		T		
	S		T		
3. Miscellaneous Property in Sec.	S		T		
	S		T		

Compliance with
ACT 345, P.A. 1990

APPROVED ON: 12-13-95
WAYNE COUNTY REMONUMENTATION
PEER GROUP COMMITTEE

Register of Deeds Stamp & File Number

4. Lot No. _____, Recorded Plat _____
5. Private Claims _____

I, **ROBERT J. SMALLEY**, in a field survey on **MARCH 23**, 1995, do hereby certify that under requirements of P.A. 74, Michigan P.A. of 1970, the corner points mentioned in lines 1 and 2 above were in conformance with regulations and rules therefore as required in the current manual of survey instructions of the United States Department of the Interior, Bureau of Land Management or by a decree of a Court of Law and/or that the cornerpoints mentioned in lines 3, 4 and 5 above were in conformance with the rules of the Michigan Board of Land Surveyors or by a Decree of a Court of Law; re-established, monumented, re-monumented, recovered, found as expressed below:

NOTE: Not more than 4 corners, all in the same town and range, may be recorded on this certificate.

A. Description of original monument and accessories and/or subsequent restoration:

GLO (1816): "POST"
WPA SURVEY (1930'S) "FOUND STONE & REPLACED WITH MONUMENT"

B. Description of corner evidence found and/or method applied in restoring or reestablishing corner:

FOUND CONCRETE MONUMENT IN MONUMENT BOX AT INTERSECTION OF JOY ROAD AND FARMINGTON ROAD (ASPHALT PAVEMENT) . CHECKED DISTANCE TO G-13, H-13 AND G-1 (WESTLAND) AGAINST DISTANCES MEASURED BY WPA SURVEY AS FOLLOWS:

G-12 to G-13 - SOUTH, 2629.91' (MEAS. 2630.19')
G-13 to H-13 - S 89°32'30" E, 2613.90' (MEAS. 2614.43')
E-13 to E-1 (WESTLAND) - EAST 57.25' (MEAS. 57.41')

NOTE: THIS CORNER IS NOT COMMON WITH CORNER G-1 OF WESTLAND, T. 2 S., R. 9 E.


C. Description of monument for corner and accessories to perpetuate locating the position of the corner:

FOUND CONCRETE MONUMENT IN MONUMENT BOX AT INTERSECTION OF JOY ROAD AND FARMINGTON ROAD (ASPHALT PAVEMENT) ; SET "WAYNE COUNTY REMONUMENTATION" TAG & SURVEY CAP NO. "30086-26467" OVER IRON IN MONUMENT.

- N. 26° W. 56.99'; SET PK NAIL IN SW ROOT OF 20" WALNUT TREE.
- N. 57° E. 111.35'; CUT CROSS IN SW BOLT OF CONCRETE LIGHT BASE.
- N. 70° E. 135.36'; CENTER LINE OF WORKING NUT ON FIRE HYDRANT.
- S. 73° E. 132.42'; CUT CROSS IN NW BOLT OF CONCRETE LIGHT BASE.
- S. 21° E. 65.52'; CUT CROSS IN NE CORNER OF CONCRETE SLAB OF MBT SWITCH BOX.

THE SELECTED LOCATION IS ACCEPTED BY THE CONTRACTOR AND IS GENERALLY ACCEPTED BY PROFESSIONAL SURVEYORS AS THE BEST AVAILABLE EVIDENCE OF THE ORIGINAL CORNER

Signed by Robert J. Smalley Date Dec. 13, 1995
ROBERT J. SMALLEY
Surveyor's Michigan License No. 26467

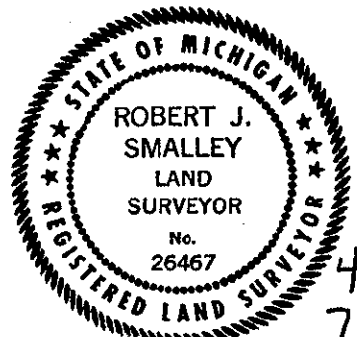

	A	B	C	D	E	F	G	H	I	J	K	L	M
1													
2	6	5	4	3	2	1							
3													
4	7	8	9	10	11	12							
5													
6	18	17	16	15	14	13							
7													
8	19	20	21	22	23	24							
9													
10	30	29	28	27	26	25							
11													
12	31	32	33	34	35	36							
13													

95268806

4R
7D
DPZ