

\$ 4.00 REMONUMENTATION

\$ 10.00 DEED

23 DEC 96 11:13 A.M. RECEI A

LAND CORNER RECORDATION CERTIFICATE

Filing Requirement of Act 74, Mich. P.A. 1970

RECORDED

FOREST E. YOUNGBLOOD, REGISTER

WAYNE COUNTY, MI

For corners in

<u>WAYNE</u> (County)	Located In: CITY OF LIVONIA	Corner Code # I-11
1. Public Land Survey	T <u>1S</u> R <u>9E</u>	_____
	T _____ R _____	_____
	T _____ R _____	_____
	T _____ R _____	_____
2. Property Controlling in Section	S _____ T _____ R _____	_____
	S _____ T _____ R _____	_____
3. Miscellaneous Property in Sec.	S _____ T _____ R _____	_____
	S _____ T _____ R _____	_____

Compliance with ACT 345, P.A. 1990 *J.P.J.*

APPROVED ON: 12-16-1996  
WAYNE COUNTY REMONUMENTATION  
PEER GROUP COMMITTEE

Register of Deeds Stamp & File Number

4. Lot No. \_\_\_\_\_, Recorded Plat \_\_\_\_\_  
5. Private Claims \_\_\_\_\_

I, PAUL V. SCHWIMMER, in a field survey on NOV 22, 1996 do hereby state that under requirements of P.A. 74, Michigan P.A. of 1970, the corner points mentioned in lines 1 and 2 above were in conformance with regulations and rules therefore as required in the current manual of survey instructions of the United States Department of the Interior, Bureau of Land Management or by a decree of a Court of Law and for that the corner points mentioned in lines 3, 4 and 5 above were in conformance with the rules of the Michigan Board of Land Surveyors or by a Decree of a Court of Law, established, re-established, monumented, recovered, found as expressed below:

NOTE: Not more than 2 corners, all in the same town and range, may be recorded on this certificate.


1	A	B	C	D	E	F	G	H	I	J	K	L
2		6		5		4		3		2		1
3												
4		7		8		9		10		11		12
5												
6		18		17		16		15		14		13
7												
8		19		20		21		22		23		24
9												
10		30		29		28		27		26		25
11												
12		31		32		33		34		35		36
13												

A. Description of original monument and accessories and/or subsequent restoration:

G.L.D. (1816) POST  
ELM 10° S 49° E 7 LINKS (GONE)  
W. OAK 6° N 66° E 13 LINKS (GONE)

1930'S BUREAU OF TAXATION - FOUND IRON SW 62.75' TEL POLE (GONE)  
NE 90.00' 24' ELM (GONE) SW 84.70' MONUMENT (GONE)  
NE 34.95' EDISON POLE (GONE) SE 71.54' EDISON POLE (GONE)

1957 - SHOWN ON PLAT OF 'DEVONSHIRE PARK SUBDIVISION' LIBER 76, PG 60  
(CONTINUED ON BACK)

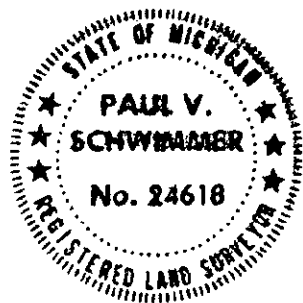

B. Description of corner evidence found and/or method applied in restoring or reestablishing corner:

FOUND 3/4" IRON ROD IN MONUMENT BOX AT THE INTERSECTION OF PLYMOUTH ROAD AND MERRIMAN ROAD. CHECKED WITNESS DISTANCES TO R.C. 403, R.C. 1373, AND DISTANCES TO J-11 AND I-12 AGAINST DISTANCES MEASURED BY THE WPA SURVEY OF 1930'S AS FOLLOWS:

R.C. 403 N 45° W 72.09 P.K. NAIL IN S.E. SIDE OF LIGHT POLE (MEAS 73.26 TO N.E.)  
N 45° E 79.44 NAIL IN DISC IN POWER POLE (MEAS 79.48)  
S 45° E 74.72 P.K. NAIL IN POWER POLE (MEAS 74.72)

(CONTINUED ON BACK)

C. Description of monument for corner and accessories established to perpetuate locating the position of the corner:

FOUND 3/4" IRON ROD IN MONUMENT BOX AT THE INTERSECTION OF PLYMOUTH ROAD AND MERRIMAN ROAD. SET 'WAYNE COUNTY REMONUMENTATION' TAG AND SURVEY CAP No. 24618 OVER IRON ROD.

N 41° E 79.48 SET NAIL AND 'WCR WITNESS' TAG IN N.W. SIDE OF UTILITY POLE  
N 53° E 82.88 SOUTHERLY BOLT OF STEEL LIGHT POLE  
S 43° E 74.52 SET NAIL AND 'WCR WITNESS' TAG IN S.W. SIDE OF UTILITY POLE  
S 41° W 75.92 FOUND 'X' IN NLY BOLT OF STEEL LIGHT POLE  
N 34° W 84.77 TOP NUT OF HYDRANT  
N 44° W 73.26 SET NAIL AND 'WCR WITNESS' TAG IN N.E. SIDE OF UTILITY POLE

THE SELECTED LOCATION AS ACCEPTED BY THE CONTRACTOR AND IS GENERALLY ACCEPTED BY THE PROFESSIONAL SURVEYORS AS THE BEST AVAILABLE EVIDENCE OF THE ORIGINAL CORNER

Signed by Paul V. Schwimmer  
Surveyor's Michigan License No. 24618

Date 11-26-1996 *J.P.J.*

CONTINUED FROM SECTION 'A'

RECORDING CERTIFICATE 403, RECORDED IN LIBER 19028, PAGE 261  
FOUND 1" IRON IN MONUMENT BOX (1975)

N 45° W 72.09 P.K. NAIL IN S.E. SIDE OF LIGHT POLE (MEAS 73.26 TO N.E.)  
N 45° E 79.44 NAIL IN DISC IN POWER POLE (MEAS 79.48)  
S 45° E 74.72 P.K. NAIL IN POWER POLE (MEAS 74.72)

RECORDING CERTIFICATE 1373, RECORDED IN LIBER 27685, PAGE 873 (1993)

FOUND 3/4" IRON ROD IN MON BOX AT APPROX INTERSECTION OF CENTERLINE OF PLYMOUTH ROAD WITH CENTERLINE OF MERRIMAN ROAD. THIS POINT FITS FAIRLY GOOD WITH MEASUREMENTS MADE BY WCRC FROM PREVIOUS WORK PERFORMED BY THEM. I BELIEVE OTHER SURVEYORS HAVE HELD THIS POINT AS GOOD, THOUGH IT IS UNRECORDED AT WAYNE COUNTY REGISTER OF DEEDS.

AZ. 43° 79.62 SET P.K. NAIL WITH TAG IN N.W. FACE OF UTILITY POLE (MEAS 79.48)  
AZ. 135° 74.71 FOUND P.K. NAIL IN N.E. FACE OF UTILITY POLE (MEAS 74.52)  
AZ. 217° 76.82 CUT "X" IN TOP OF N. BOLT OF PAD TO STEEL SIGNAL POLE (MEAS 75.92)  
AZ. 313° 73.28 FOUND P.K. NAIL IN N.E. FACE OF UTILITY POLE (MEAS 73.26)

CONTINUED FROM SECTION 'B'

R.C. 1373

AZ. 43° 79.62 SET P.K. NAIL WITH TAG IN N.W. FACE OF UTILITY POLE (MEAS 79.48)  
AZ. 135° 74.71 FOUND P.K. NAIL IN N.E. FACE OF UTILITY POLE (MEAS 74.52)  
AZ. 217° 76.82 CUT "X" IN TOP OF N. BOLT OF PAD TO STEEL SIGNAL POLE (MEAS 75.92)  
AZ. 313° 73.28 FOUND P.K. NAIL IN N.E. FACE OF UTILITY POLE (MEAS 73.26)

I-11 TO J-11 N 89°49'00" E 2623.61 RECORDED 2623.66 MEASURED  
I-11 TO I-12 S 00°07'30" E 2635.31 RECORDED 2635.61 MEASURED

FILE DU INUI MAIL