

DEC 28 1998

SURVEY & REMONUMENTATION

FILE DO NOT MAIL

LAND CORNER RECORDATION CERTIFICATE Filing Requirement of Act 74, Mich. P.A. 1970

MAR 02 1999

For corners in

<u>WAYNE</u> (County)	Located In: CITY OF LIVONIA	Corner Code #
1. Public Land Survey	T <u>1S</u> R <u>9E</u>	<u>J-11</u>
	T <u>   </u> R <u>   </u>	<u>   </u>
	T <u>   </u> R <u>   </u>	<u>   </u>
	T <u>   </u> R <u>   </u>	<u>   </u>
2. Property Controlling in Section	S <u>   </u> T <u>   </u> R <u>   </u>	<u>   </u>
	S <u>   </u> T <u>   </u> R <u>   </u>	<u>   </u>
3. Miscellaneous Property in Sec.	S <u>   </u> T <u>   </u> R <u>   </u>	<u>   </u>
	S <u>   </u> T <u>   </u> R <u>   </u>	<u>   </u>

SECTION

Compliance with ACT 345, P.A. 1990

APPROVED ON: 12-15-98 *DPJ*

WAYNE COUNTY REMONUMENTATION PEER GROUP COMMITTEE

Register of Deeds Stamp & File Number

4. Lot No. \_\_\_\_\_, Recorded Plat \_\_\_\_\_

5. Private Claims \_\_\_\_\_

I, PAUL V. SCHWIMMER, in a field survey on NOV 19, 1998 do hereby state that under requirements of P.A. 74, Michigan P.A. of 1970, the corner points mentioned in lines 1 and 2 above were in conformance with regulations and rules therefore as required in the current manual of survey instructions of the United States Department of the Interior, Bureau of Land Management or by a decree of a Court of Law and /or that the corner points mentioned in lines 3, 4 and 5 above were in conformance with the rules of the Michigan Board of Land Surveyors or by a Decree of a Court of Law, established, re-established, monumented, recovered, found as expressed below:

NOTE: Not more than 2 corners, all in the same town and range, may be recorded on this certificate.

1	A	B	C	D	E	F	G	H	I	J	K	L	M
2	6		5		4		3		2		1		
3													
4	7		8		9		10		11		12		
5													
6	10		17		16		15		14		13		
7													
8	19		20		21		22		23		24		
9													
10	30		29		28		27		26		25		
11													
12	31		32		33		34		35		36		
13													

A. Description of original monument and accessories and/or subsequent restoration:

GOVERNMENT LAND OFFICE (1816) SET 1/4 POST BEECH 16" S 76°E .12 CHAINS (1) (GONE)  
SUGAR 6" N 12°E .11 CHAINS (2) (GONE)

FEB. 11, 1975 L.C.R.C. 403, W.C.R. FOUND 3/4" IRON (8)  
N 30°W 62.45' NAIL E-SIDE P.P. (9) (GONE)  
S 60°E 82.17' NAIL S-SIDE P.P. (10) (GONE)  
S 30°W 31.97' CROSS IN RIM OF STORM M.H. (11) (FOUND)

1930'S WAYNE COUNTY BUREAU OF TAXATION WITNESSES;  
DRILL HOLE IN PAVEMENT (3) (GONE)  
NORTH 35.80' FENCE POST (4) (GONE)  
N.E. 39.64' EDISON POLE (5) (GONE)  
S.E. 40.44' TELEPHONE POLE (6) (GONE)  
S.W. 145.22' TELEPHONE POLE (6) (GONE)  
N.W. 134.77' EDISON POLE (7) (GONE)

B. Description of corner evidence found and/or method applied in restoring or reestablishing corner:

FOUND 3/4" IRON ROD IN MONUMENT BOX IN THE CENTERLINE OF PLYMOUTH ROAD (ASPHALT) ON THE RANGE OF HENRY RUFF ROAD SOUTHERLY. NONE OF THE 1930 WITNESSES REMAINED. I FOUND ONE OF THE 1975 WITNESSES BEING THE STORM MANHOLE TO THE S.W. ALTHOUGH I COULD NOT VISUALLY SEE THE "X" IN THE RIM, THE DISTANCE TO THE EDGE MEASURED WELL. I VERIFIED THIS CORNER'S POSITION BY MEASURING TO THE EAST, WEST, AND SOUTH, AND CHECKING THIS INFORMATION AGAINST THE 1930 RESURVEY INFORMATION.

- \* J-11 TO J-13: 5279.01 COMPUTED VERSUS 5279.91 MEASURED.
- \* J-11 TO I-11: 2623.61 RECORDED VERSUS 2623.65 MEASURED.
- \* J-11 TO K-11: 2622.97 RECORDED VERSUS 2623.61 MEASURED.
- \* THE ANGLE OF I-11 - J-11 - K-11 IS 179°41'40" RECORDED VERSUS 179°41'30" MEASURED.

C. Description of monument for corner and accessories established to perpetuate locating the position of the corner:


FOUND 3/4" IRON ROD IN MONUMENT BOX IN THE CENTERLINE OF PLYMOUTH ROAD (ASPHALT). I SET A 1" IRON PIPE AND REMONUMENTATION DISC OVER THE ROD.  
N 36°E 63.00' UTILITY POLE WITH NAIL & TAG IN N.W. SIDE  
S 52°E 75.08' TOP NUT OF HYDRANT  
S 27°E 78.93' N.W. CORNER OF WOOD SIDED BUILDING  
S 15°E 41.70' N.W. BOLT ON BASE OF LIGHT POLE BASE  
S 30°W 31.97' (32.00' MEAS) NORTH EDGE OF RIM OF STORM MANHOLE (11)  
N 50°W 80.63' TOP NUT OF HYDRANT

THE SELECTED LOCATION IS ACCEPTED BY THE CONTRACTOR AND IS GENERALLY ACCEPTED BY PROFESSIONAL SURVEYORS AS THE BEST AVAILABLE EVIDENCE OF THE POSITION OF THE ORIGINAL CORNER.

Signed by Paul V. Schwimmer  

Date 12-13-1998

R LCR 7 4R 1PG V. *DPJ*

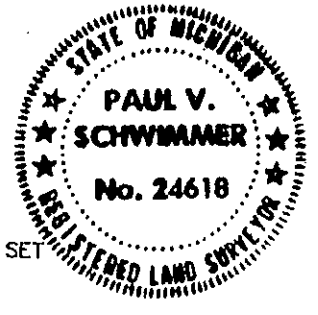

RECORDED  
FOREST E. YOUNGBLOOD, REGISTER OF DEEDS  
WAYNE COUNTY, MI  
Receipt #101787

Liber-30034  
Page-444.0  
12/28/1998  
09:12AM