SURVEY
RECORDED
FEB 28 1994
COMMISSIONER

RC 1228

L127004PA584

LAND CORNER RECORDATION CERTIFICATE
Filing requirement of Act 74, Mich. P.A. 1970

For corners in WAYNE COUNTY (County)

Located In:

Corner Code #

Compliance with ACT 345, P.A. 1990

APPROVED ON: 12/3/93 MCD
WAYNE COUNTY REMONUMENTATION PEER GROUP COMMITTEE

Register of Deeds Stamp & File Number

		T	R	Corner Code #
1. Public Land Survey		T 1 S	R 9 E	K-1
		T	R	
		T	R	
		T	R	
2. Property Controlling	S	T	R	
in Section	S	T	R	
3. Miscellaneous	S	T	R	
Property in Sec.	S	T	R	

4. Lot No. _____, Recorded Plat _____
5. Private Claims _____

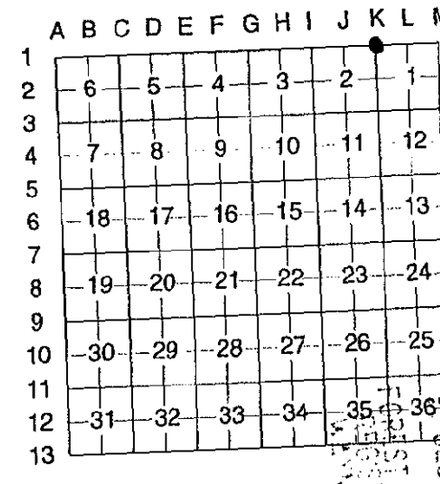

I, ROBERT J. SMALLEY, in a field survey on NOVEMBER 29, 19 93, do hereby certify that under requirements of P.A. 74, Michigan P.A. of 1970, the corner points mentioned in lines 1 and 2 above were in conformance with regulations and rules therefore as required in the current manual of survey instructions of the United States Department of the Interior, Bureau of Land Management or by a decree of a Court of Law and/or that the cornerpoints mentioned in lines 3, 4 and 5 above were in conformance with the rules of the Michigan Board of Land Surveyors or by a Decree of a Court of Law; re-established, monumented, re-monumented, recovered, found as expressed below:

NOTE: Not more than 4 corners, all in the same town and range, may be recorded on this certificate.

A. Description of original monument and accessories and/or subsequent restoration:

GLO (1816): "POST"
WPA (1930's): "IRON NW-1"
LCRC (1973): "FOUND 1/2" IRON" (RC-289; L. 18645, P. 39)
LCRC (1992): "FOUND CONCRETE MONUMENT IN MONUMENT BOX" (RC-1044; L. 25755, P. 661)

B. Description of corner evidence found and/or method applied in restoring or reestablishing corner:

FOUND CONCRETE MONUMENT (WITH 1/2" IRON BAR) IN MONUMENT BOX; CHECKED WITNESSES RECORDED IN RC-1044 AS FOLLOWS:

Az. 13°, 56.71'; NAIL WITH WCRC TAG IN SE FACE UTILITY POLE. (POINT NOT FOUND)
Az. 73°, 130.40'; NAIL WITH WCRC TAG IN SOUTH FACE UTILITY POLE. (MEAS. N 69° E, 130.37')
Az. 128°, 110.18'; CHISELED "X" IN NE CORNER CONCRETE BASE OF TRAFFIC "WALK-DONT WALK" SIGN. (MEAS. S 51° E, 110.18')
Az. 202°, 63.89'; CHISELED "X" IN NW CORNER BASE OF LIGHT POLE (MEAS. S 18° W, 63.91')

C. Description of monument for corner and accessories to perpetuate locating the position of the corner:

FOUND CONCRETE MONUMENT (WITH 1/2" IRON BAR) IN MONUMENT BOX AT INTERSECTION OF EIGHT MILE ROAD AND MIDDLEBELT ROAD; SET "WAYNE COUNTY REMONUMENTATION" TAG AND SURVEY CAP NO. "30086-26467" OVER IRON BAR IN MONUMENT.

N. 08° E. 56.54'; SET NAIL WITH "WCR WITNESS" TAG IN SOUTHEAST FACE OF UTILITY POLE
N. 69° E. 130.37'; SET NAIL WITH "WCR WITNESS" TAG IN SOUTH FACE OF UTILITY POLE.
S. 57° E. 110.18'; FOUND CHISELED "X" IN NORTHEAST CORNER OF CONCRETE BASE OF PEDESTRIAN TRAFFIC SIGNAL.
S. 18° W. 63.91'; FOUND CHISELED "X" IN NORTHWEST CORNER CONCRETE LIGHT POLE BASE.

THE SELECTED LOCATION IS ACCEPTED BY THE CONTRACTOR AND IS GENERALLY ACCEPTED BY PROFESSIONAL SURVEYORS AS THE BEST AVAILABLE EVIDENCE OF THE ORIGINAL CORNER.

Signed by Robert J. Smalley Date Nov. 30, 1993
ROBERT J. SMALLEY

Surveyor's Michigan License No. 26467