

MAR 17 1998

LAND CORNER RECORDATION CERTIFICATE
Filing Requirement of Act 74, Mich. P.A. 1970

For corners in

<u>WAYNE</u>	SECTION	Located In:	Corner Code #
(County)		CITY OF LIVONIA	
1. Public Land Survey	T <u>1S</u> R <u>9E</u>		K-10
	T <u> </u> R <u> </u>		
	T <u> </u> R <u> </u>		
	T <u> </u> R <u> </u>		
2. Property Controlling in Section	S <u> </u> T <u> </u> R <u> </u>		
	S <u> </u> T <u> </u> R <u> </u>		
3. Miscellaneous Property in Sec.	S <u> </u> T <u> </u> R <u> </u>		
	S <u> </u> T <u> </u> R <u> </u>		

Compliance with
ACT 345, P.A. 1990

APPROVED ON: 12-8-97

WAYNE COUNTY REMONUMENTATION
PEER GROUP COMMITTEE

Register of Deeds Stamp & File Number

4. Lot No. _____, Recorded Plat _____
5. Private Claims _____

I, PAUL V. SCHWIMMER, in a field survey on NOV 19, 19 97 do hereby state that under requirements of P.A. 74, Michigan P.A. of 1970, the corner points mentioned in lines 1 and 2 above were in conformance with regulations and rules therefore as required in the current manual of survey instructions of the United States Department of the Interior, Bureau of Land Management or by a decree of a Court of Law and/or that the corner points mentioned in lines 3, 4 and 5 above were in conformance with the rules of the Michigan Board of Land Surveyors or by a Decree of a Court of Law, established, re-established, monumented, recovered, found as expressed below:

NOTE: Not more than 2 corners, all in the same town and range, may be recorded on this certificate.

1	A	B	C	D	E	F	G	H	I	J	K	L	M
2	6		5		4		3		2		1		
3													
4	7		8		9		10		11		12		
5													
6	18		17		16		15		14		13		
7													
8	19		20		21		22		23		24		
9													
10	30		29		28		27		26		25		
11													
12	31		32		33		34		35		36		
13													

A. Description of original monument and accessories and/or subsequent restoration:

- GOVERNMENT LAND OFFICE (1830'S) SET 1/4 POST
- B. OAK 16° S 40°W .24 CHAINS (1) (GONE)
- IRONWOOD 6° N 69°W .14 CHAINS (2) (GONE)
- 1930'S WAYNE COUNTY BUREAU OF TAXATION WITNESSES;
- IRON
- N.E. 71.00' 20° MAPLE (3) (GONE)
- S.E. 60.42' 18° MAPLE (4) (GONE)
- S.W. 63.37' EDISON POLE (5) (GONE)
- N.W. 49.03' FOUNDATION OF SIGNAL BOX (6) (GONE)

(SKETCH SHOWS THE CORNER TO BE 11.79 FEET NORTH OF THE SOUTHERLY RAIL OF THE EASTBOUND TRACK)


\$10.00 DEED
RECORDED
FOREST E. YOUNGLOOD, REGISTER OF DEEDS
WAYNE COUNTY, MI
Receipt #43171

CONTINUED ON BACK

B. Description of corner evidence found and/or method applied in restoring or reestablishing corner:

\$4.00 REMONUMENTATION

THE POSITION OF K-10 IS UNSTABLE FOR THE PLACEMENT OF A PERMANENT POINT. IT IS MY RECOMMENDATION TO TIE IN THE FOUR PUNCH HOLES AND PREFORM A RESECTION. A POSITION CREATED BY THIS TECHNIQUE CHECKS IN WELL WITH THE MONUMENTS SET NORTHLY AND SOUTHERLY. THESE MONUMENTS WERE SET BY THE WAYNE COUNTY ROAD COMMISSION AS REFERENCE POINTS TO THIS CORNER PRIOR TO ITS REMOVAL FOR CONSTRUCTION OF THE EXISTING RAILROAD BRIDGE.

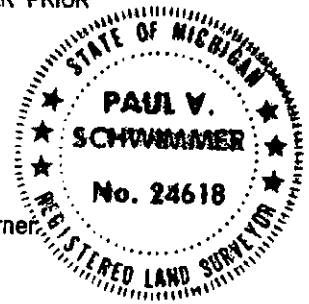

C. Description of monument for corner and accessories established to perpetuate locating the position of the corner:

THERE IS NO PERMANENT MARK SET AT THIS POSITION DUE TO THE RAILROAD TRAFFIC AND UNSTABLENESS OF THE LIMESTONE RAILROAD BED. USE A DISTANCE DISTANCE RESECTION TO OBTAIN ITS POSITION.

- N.W. 72.61 FEET TO PUNCH MARK ON C/L OF NORTH FACIA GIRDER ± 2" FROM WEST END. (7)
- N.E. 72.66 FEET TO PUNCH MARK ON C/L OF NORTH FACIA GIRDER ± 2" FROM WEST END. (8)
- S.E. 64.68 FEET TO PUNCH MARK ON C/L OF NORTH FACIA GIRDER ± 2" FROM WEST END. (9)
- S.W. 64.77 FEET TO PUNCH MARK ON C/L OF NORTH FACIA GIRDER ± 2" FROM WEST END. (10)
- NORTH 842.18 FEET TO CONC. MON. IN MON BOX IN SECTION LINE
- SOUTH 757.92 FEET TO CONC. MON IN MON BOX IN SECTION LINE
- N 55° E 118.02 SET NAIL AND REMON TAG IN S.E. SIDE OF UTIL POLE

THE SELECTED LOCATION IS ACCEPTED BY THE CONTRACTOR AND IS GENERALLY ACCEPTED BY PROFESSIONAL SURVEYORS AS THE BEST AVAILABLE EVIDENCE OF THE POSITION OF THE ORIGINAL CORNER.

Signed by Paul V. Schwimmer
Surveyor's Michigan License No. 24618

Date 12-16-1997

SECTION "A" CONTINUED:

IN 1975 AND 1976 A MR. TOM O'CONNER OF THE WAYNE COUNTY ROAD COMMISSION STATES ON ACT 74, LIBER 19441, PAGE 229, W.C.R. THAT HE RECOVERED A FOUND CONCRETE MONUMENT IN A MONUMENT BOX AT K-10. HE THEN USED THIS POINT TO SET A REFERENCE MONUMENT 757.89 FEET AND ON LINE TO THE SOUTH, AND ALSO TO SET A REFERENCE MONUMENT 842.15 FEET AND ON LINE TO THE NORTH. DURING THE RE-CONSTRUCTION OF MIDDLEBELT ROAD, K-10 WAS REMOVED AND AN ELEVATED RAILROAD BRIDGE WAS BUILT ON ITS LOCATION. MR. O'CONNER THEN FELT THAT HE COULD NOT SET A PERMANENT MARKER AT ITS LOCATION AND CALLED IT AN "UNSTABLE POSITION" DUE TO THE RAILROAD TRAFFIC AND LIMESTONE MATERIAL TO SUPPORT THE TRACKS. HE SET THE FOLLOWING FOUR WITNESSES:

N.W. 72.81 FEET TO PUNCH MARK ON C/L OF NORTH FACIA GIRDER \pm 2" FROM WEST END. (7) (FOUND)
N.E. 72.66 FEET TO PUNCH MARK ON C/L OF NORTH FACIA GIRDER \pm 2" FROM WEST END. (8) (FOUND)
S.E. 64.68 FEET TO PUNCH MARK ON C/L OF NORTH FACIA GIRDER \pm 2" FROM WEST END. (9) (FOUND)
S.W. 64.77 FEET TO PUNCH MARK ON C/L OF NORTH FACIA GIRDER \pm 2" FROM WEST END. (10) (FOUND)

WITNESSES TO THE REFERENCE POINT SOUTHERLY ARE RECORDED ON LIBER 19441, PG 230. W.C.R.

WITNESSES TO THE REFERENCE POINT NORTHERLY ARE RECORDED ON LIBER 19441, PG 226, W.C.R.

SECTION

MAR 17 1998

SURVEY &
REMONUMENTATION

15-11-11

81000