SURVEY &
REMONUMENTATION

RC 1477

APR 2 5 1995

COMMISSION

LAND CORNER RECORDATION CERTIFICATE
Filing requirement of Act 74, Mich. P.A. 1970

L127796PA705

Compliance with
ACT 345, P.A. 1990

APPROVED ON: 12-12-94
WAYNE COUNTY REMONUMENTATION
PEER GROUP COMMITTEE

Register of Deeds Stamp & File Number

For corners in
WAYNE COUNTY
(County)

		Located In:		Corner Code #
1. Public Land Survey		T 1 S	R 9 E	K - 13
		T	R	
		T	R	
		T	R	
2. Property Controlling	S	T	R	
in Section	S	T	R	
3. Miscellaneous	S	T	R	
Property in Sec.	S	T	R	

4. Lot No. _____, Recorded Plat _____
5. Private Claims _____

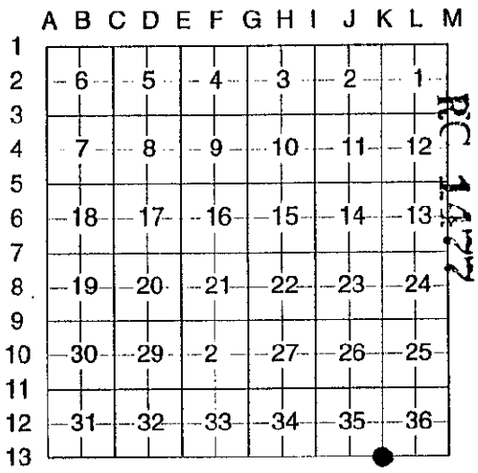

I, **ROBERT J. SMALLEY**, in a field survey on **SEPTEMBER 1**, 19 **94**, do hereby certify that under requirements of P.A. 74, Michigan P.A. of 1970, the corner points mentioned in lines 1 and 2 above were in conformance with regulations and rules therefore as required in the current manual of survey instructions of the United States Department of the Interior, Bureau of Land Management or by a decree of a Court of Law and/or that the cornerpoints mentioned in lines 3, 4 and 5 above were in conformance with the rules of the Michigan Board of Land Surveyors or by a Decree of a Court of Law; re-established, monumented, re-monumented, recovered, found as expressed below:

NOTE: Not more than 4 corners, all in the same town and range, may be recorded on this certificate.

$ 13.00 MISCELLANEOUS RECORDING
22 DEC 94 3:40 P.M. RECEIPT# 93A
RECORDED
FOREST E. YOUNGBLOOD, REGISTER OF DEEDS
WAYNE COUNTY, MI

A. Description of original monument and accessories and/or subsequent restoration:

GLO (1816): "POST"
WPA(1930'S): "IRON"

B. Description of corner evidence found and/or method applied in restoring or reestablishing corner:

FOUND CONCRETE MONUMENT (WITH 1/2" BAR) IN MONUMENT BOX AT THE INTERSECTION OF JOY ROAD AND MIDDLEBELT ROAD). CHECKED DISTANCES TO K-12, L-13 AND K-1 (WESTLAND) AGAINST DISTANCES MEASURED BY WPA SURVEY OF 1930'S AS FOLLOWS:

K-13 TO K-12	N. 00°10'00" W.	2634.37'	(MEAS. 2633.71')
K-13 TO L-13	N. 89°59'30" E.	2648.10'	(MEAS. 2648.84')
K-13 TO K-1 (WESTLAND)	EAST	34.81'	(MEAS. 34.81')

C. Description of monument for corner and accessories to perpetuate locating the position of the corner:

FOUND CONCRETE MONUMENT (WITH 1/2" BAR) IN MONUMENT BOX (IN PAVEMENT) AT THE INTERSECTION OF JOY ROAD AND MIDDLEBELT ROAD; SET "WAYNE COUNTY REMONUMENTATION" TAG AND CAP No. "30086-26467" OVER BAR IN MONUMENT.

EAST	35.23';	FOUND CONCRETE MONUMENT (WITH 1/2" BAR) IN MONUMENT BOX AT OR NEAR CORNER K-1 (WESTLAND)
S. 55° E.	101.32';	SET NAIL AND "WCR WITNESS" TAG IN NORTHEAST FACE OF UTILITY POLE
S. 06° W.	61.17';	SET NAIL AND "WCR WITNESS" TAG IN EAST FACE OF UTILITY POLE
N. 42° W.	57.37';	CENTER LINE OF SOUTHWEST BOLT OF LIGHT POLE BASE
N. 48° E.	94.44';	SET NAIL AND "WCR WITNESS" TAG IN NORTHWEST FACE OF UTILITY POLE

THE SELECTED LOCATION IS ACCEPTED BY THE CONTRACTOR AND IS GENERALLY ACCEPTED BY PROFESSIONAL SURVEYORS AS THE BEST AVAILABLE EVIDENCE OF THE ORIGINAL CORNER.

STATE OF MICHIGAN
ROBERT J. SMALLEY
LAND SURVEYOR
No. 26467
REGISTERED LAND SURVEYOR

Signed by Robert J. Smalley Date 12-22-94
ROBERT J. SMALLEY
Surveyor's Michigan License No. 26467