SURVEY &
REMONUMENTATION

APR 2 5 1995

COMMISSION

RC 1478

$ 13.00 MISCELLANEOUS RECORDING
22 DEC 94 3:40 P.M. RECEIPT# 930
RECORDED
JAMES E. YOUNGBLOOD, REGISTER OF DEEDS
WAYNE COUNTY, MI

LAND CORNER RECORDATION CERTIFICATE

Filing requirement of Act 74, Mich. P.A. 1970

L127796PA706

For corners in **WAYNE COUNTY** (County) Located In: Corner Code #

1. Public Land Survey		T 1 S	R 9 E	L - 13
		T	R	
		T	R	
		T	R	
2. Property Controlling	S	T	R	
in Section	S	T	R	
3. Miscellaneous	S	T	R	
Property in Sec.	S	T	R	

Compliance with
ACT 345, P.A. 1990

APPROVED ON: 12 12-94
WAYNE COUNTY REMONUMENTATION
PEER GROUP COMMITTEE

Register of Deeds Stamp & File Number

4. Lot No. _____, Recorded Plat _____
5. Private Claims _____

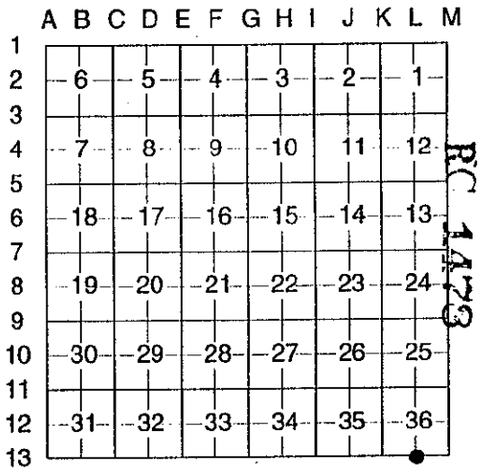

RC 1478

I, **ROBERT J. SMALLEY**, in a field survey on **SEPTEMBER 2**, 19 **94**, do hereby certify that under requirements of P.A. 74, Michigan P.A. of 1970, the corner points mentioned in lines 1 and 2 above were in conformance with regulations and rules therefore as required in the current manual of survey instructions of the United States Department of the Interior, Bureau of Land Management or by a decree of a Court of Law and/or that the cornerpoints mentioned in lines 3, 4 and 5 above were in conformance with the rules of the Michigan Board of Land Surveyors or by a Decree of a Court of Law; re-established, monumented, re-monumented, recovered, found as expressed below:

NOTE: Not more than 4 corners, all in the same town and range, may be recorded on this certificate.

A. Description of original monument and accessories and/or subsequent restoration:

GLO (1816): "POST"
WPA SURVEY (1930'S) "IRON"
LCRC (1981): "FOUND CONC. MONUMENT IN MINUMENT BOX" (RC 746, L. 21061, P. 669)

B. Description of corner evidence found and/or method applied in restoring or reestablishing corner:

FOUND CONCRETE MONUMENT (WITH 1/2" BAR) IN MONUMENT BOX AT THE INTERSECTION OF JOY ROAD AND HARRISON ROAD. CHECKED CORNER WITNESSES AGAINST DISTANCES SHOWN IN (RC 746 L. 21061, P. 669) AS FOLLOWS:

N. 55°E.	65.75';	"CENTER OF FIRE HYDRANT"	(MEAS. N. 52° E, 65.79')
EAST	16.41';	"FOUND MOUNUMENT IN MOUNMENT BOX"	(MEAS. EAST, 16.42')
S. 40°E.	53.36';	"NORTHWEST BOLT OF LIGHT POLE BASE"	(MEAS. S. 43° E, 53.31')
SOUTH	40.38';	"CENTER OF FIRE HYDRANDT	(MEAS. SOUTH, 40.31')
N. 40°W.	50.39';	"SOUTHEAST BOLT OF LIGHT POLE BASE"	(MEAS. N. 41° W, 50.44')

C. Description of monument for corner and accessories to perpetuate locating the position of the corner:

FOUND CONCRETE MONUMENT (WITH 1/2 BAR) IN MONUMENT BOX (IN PAVEMENT) AT THE INTERSECTION OF JOY ROAD AND HARRISON ROAD; SET "WAYNE COUNTY REMONUMENTATION" TAG AND SURVEY CAP NO. "30086-26467" OVER BAR IN MONUMENT.

EAST	16.42';	FOUND CONCRETE MONUMENT (WITH 1/2" BAR) IN MONUMENT BOX AT OR NEAR CORNER L-1 (WESTLAND).
S. 43°E.	53.31';	CENTER LINE OF NW BOLT OF CONCRETE LIGHT POLE BASE.
SOUTH.	40.31';	CENTER OF WORKING NUT OF FIRE HYDRANT.
N. 41°W	32.97';	CENTER LINE OF SE BOLT OF CONCRETE LIGHT POLE BASE.
N. 52°E.	65.79';	CENTER OF WORKING NUT OF FIRE HYDRANT.

2 e
11 0
MS

THE SELECTED LOCATION IS ACCEPTED BY THE CONTRACTOR AND IS GENERALLY ACCEPTED BY PROFESSIONAL SURVEYORS AS THE BEST AVAILABLE EVIDENCE OF THE ORIGINAL CORNER

STATE OF MICHIGAN
ROBERT J. SMALLEY
LAND SURVEYOR
No. 26467
REGISTERED LAND SURVEYOR

Signed by Robert J. Smalley Date 12-22-94
ROBERT J. SMALLEY
Surveyor's Michigan License No. 26467