

APR 05 1996

**LAND CORNER RECORDATION CERTIFICATE**

Filing requirement of Act 74, Mich. P.A. 1970

**COMMISSION**

For corners in WAYNE COUNTY  
 (County)

Located in: LIVONIA Corner Code #

LIBER 28465 PAGE 792

Compliance with  
 ACT 345, P.A. 1990

APPROVED ON: 12-13-95 *DBJ*  
 WAYNE COUNTY REMONUMENTATION  
 PEER GROUP COMMITTEE

Register of Deeds Stamp & File Number

- |                                    |   |            |   |            |              |
|------------------------------------|---|------------|---|------------|--------------|
| 1. Public Land Survey              | T | <u>1 S</u> | R | <u>9 E</u> | <u>M - 2</u> |
|                                    | T |            | R |            |              |
|                                    | T |            | R |            |              |
|                                    | T |            | R |            |              |
| 2. Property Controlling in Section | S |            | T |            |              |
|                                    | S |            | T |            |              |
| 3. Miscellaneous Property in Sec.  | S |            | T |            |              |
|                                    | S |            | T |            |              |
4. Lot No. \_\_\_\_\_, Recorded Plat \_\_\_\_\_  
 5. Private Claims \_\_\_\_\_

	A	B	C	D	E	F	G	H	I	J	K	L	M
1													
2	6	5	4	3	2	1							
3													
4	7	8	9	10	11	12							
5													
6	18	17	16	15	14	13							
7													
8	19	20	21	22	23	24							
9													
10	30	29	28	27	26	25							
11													
12	31	32	33	34	35	36							
13													

I, ROBERT J. SMALLEY, in a field survey on NOVEMBER 14, 1995, do hereby certify that under requirements of P.A. 74, Michigan P.A. of 1970, the corner points mentioned in lines 1 and 2 above were in conformance with regulations and rules therefore as required in the current manual of survey instructions of the United States Department of the Interior, Bureau of Land Management or by a decree of a Court of Law and/or that the cornerpoints mentioned in lines 3, 4 and 5 above were in conformance with the rules of the Michigan Board of Land Surveyors or by a Decree of a Court of Law; re-established, monumented, re-monumented, recovered, found as expressed below:

NOTE: Not more than 4 corners, all in the same town and range, may be recorded on this certificate.

A. Description of original monument and accessories and/or subsequent restoration:

- GLO (1816): "POST"
- WPA SURVEY (1930'S) "MON"
- LCRC (1977): "FOUND MONUMENT IN BOX" (RC 724; L. 20861, P. 368)

B. Description of corner evidence found and/or method applied in restoring or reestablishing corner:

FOUND CONCRETE MONUMENT (WITH 1/2" PIPE) IN MONUMENT BOX AT THE INTERSECTION OF INKSTER ROAD AND PEMBROKE AVE. CHECKED CORNER WITNESSES RECORDED IN RC 724 AND DISTANCE TO M-1 AND M-3 AGAINST DISTANCES MEASURED BY WPA SURVEY AS FOLLOWS:

- N.W. 52.05'; SPIKE IN SE SIDE OF 18" MAPLE (NOW 28" MAPLE) (SPIKE NOT FOUND)
- N.E. 45.14'; P.K. NAIL IN SW SIDE DE POLE (POLE REMOVED)
- S.E. 62.16'; NE CORNER OF HOUSE #19816 (MEAS. S 51° E, 67.14')
- S.W. 48.02'; MON AT NE CORNER OF "BOTSFORD PARK SUB'N" (MON REMOVED BY WIDENING)

- M-1 to M-2 - S 0°28'40" W, 2643.28' (MEAS. 2643.29')
- M-2 to M-3 - S 0°31'40" W, 2624.45' (MEAS. 2624.60')

NOTE: THIS CORNER IS COMMON WITH CORNER A-2 OF REDFORD TOWNSHIP, T. 1 S., R. 10 E.


C. Description of monument for corner and accessories to perpetuate locating the position of the corner:

FOUND CONCRETE MONUMENT (WITH 1/2" PIPE) IN MONUMENT BOX AT THE INTERSECTION OF INKSTER ROAD AND PEMBROKE AVE. (ASPHALT PAVEMENT); SET "WAYNE COUNTY REMONUMENTATION" TAG AND SURVEY CAP NO. "30086-26467" OVER IRON PIPE IN MONUMENT.

- N. 57° E. 81.56'; S.W. CORNER OF CONCRETE FOUNDATION OF HOUSE # 19906 INKSTER RD.
- S. 51° E. 67.14'; N.W. CORNER OF OUTSIDE BRICK WALL OF HOUSE # 19816 INKSTER RD.
- S. 50° W. 68.54'; FOUND IRON BAR AT S.W. CORNER OF PEMBROKE & INKSTER RD. (AS WIDENED)
- N. 44° W. 51.53'; SET PK NAIL AND "WCR WITNESS" TAG IN NE FACE OF 28" MAPLE TREE

THE SELECTED LOCATION IS ACCEPTED BY THE CONTRACTOR AND IS GENERALLY ACCEPTED BY PROFESSIONAL SURVEYORS AS THE BEST AVAILABLE EVIDENCE OF THE ORIGINAL CORNER

Signed by Robert J. Smalley Date Dec. 13, 1995  
 ROBERT J. SMALLEY  
 Surveyor's Michigan License No. 26467

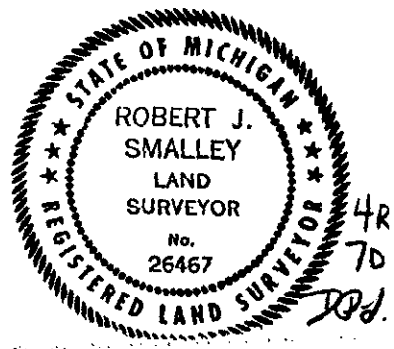

95268808