

APR 05 1996

LAND CORNER RECORDATION CERTIFICATE
Filing requirement of Act 74, Mich. P.A. 1970

COMMISSION

For corners in

WAYNE COUNTY (County)

Located In: LIVONIA Corner Code #

LIBER 28465 PAGE 793

Compliance with ACT 345, P.A. 1990

APPROVED ON: 12-13-95
WAYNE COUNTY REMONUMENTATION PEER GROUP COMMITTEE

Register of Deeds Stamp & File Number

Table with 3 columns: Survey Type, Township/Range, and Corner Code. Includes rows for Public Land Survey, Property Controlling in Section, and Miscellaneous Property in Sec.

4. Lot No. , Recorded Plat
5. Private Claims

I, ROBERT J. SMALLEY, in a field survey on NOVEMBER 14, 1995, do hereby certify that under requirements of P.A. 74, Michigan P.A. of 1970, the corner points mentioned in lines 1 and 2 above were in conformance with regulations and rules therefore as required in the current manual of survey instructions of the United States Department of the Interior, Bureau of Land Management or by a decree of a Court of Law and/or that the cornerpoints mentioned in lines 3, 4 and 5 above were in conformance with the rules of the Michigan Board of Land Surveyors or by a Decree of a Court of Law; re-established, monumented, re-monumented, recovered, found as expressed below:

NOTE: Not more than 4 corners, all in the same town and range, may be recorded on this certificate.

Grid table with columns A-M and rows 1-13. Contains numbers 1-36 in a grid pattern.

A. Description of original monument and accessories and/or subsequent restoration:

GLO (1816): POST
WPA SURVEY (1930'S) IRON

\$ 4.00 REMONUMENTATION
\$ 7.00 DEED
15 DEC 95 11:22 A.M. RECEI
RECORDED
FOREST E. YOUNGBLOOD, REGISTER
WAYNE COUNTY, MI

B. Description of corner evidence found and/or method applied in restoring or reestablishing corner:

FOUND CONCRETE MONUMENT IN MONUMENT BOX AT THE INTERSECTION OF INKSTER ROAD AND SEVEN MILE RD. CHECKED DISTANCE TO L-3 AND M-2 AGAINST DISTANCES MEASURED BY WPA SURVEY AS FOLLOWS:

L-3 to M-3 - S 89°07'50" E, 2679.35' (MEAS. 2679.64')
M-2 to M-3 - S 0°31'40" W, 2624.45' (MEAS. 2624.60')
ANGLE L-3,M-3,M-2 89°39'30" (MEAS. 89°39'04")

NOTE: THIS CORNER IS COMMON WITH CORNER A-3 OF REDFORD TOWNSHIP, T. 1 S., R. 10 E.


C. Description of monument for corner and accessories to perpetuate locating the position of the corner:

FOUND CONCRETE MONUMENT IN MONUMENT BOX AT THE INTERSECTION OF INKSTER ROAD AND SEVEN MILE RD. (ASPHALT PAVEMENT); SET "WAYNE COUNTY REMONUMENTATION" TAG AND SURVEY CAP NO. "30086-26467" OVER IRON IN MONUMENT.

N. 28° E. 67.63'; FOUND NAIL WITH "WCRC" TAG IN SE FACE OF UTILITY POLE.
S. 56° E. 56.16'; FOUND NAIL WITH "WCRC" TAG IN SW FACE OF UTILITY POLE.
S. 44° W. 85.01'; FOUND IRON BAR AT S.W. CORNER OF SEVEN MILE RD. & INKSTER RD.
N. 36° W. 76.06'; FOUND NAIL WITH "WCRC" TAG IN NE FACE OF UTILITY POLE.

THE SELECTED LOCATION IS ACCEPTED BY THE CONTRACTOR AND IS GENERALLY ACCEPTED BY PROFESSIONAL SURVEYORS AS THE BEST AVAILABLE EVIDENCE OF THE ORIGINAL CORNER

Signed by Robert J. Smalley Date Dec 13, 1995
ROBERT J. SMALLEY
Surveyor's Michigan License No. 26467

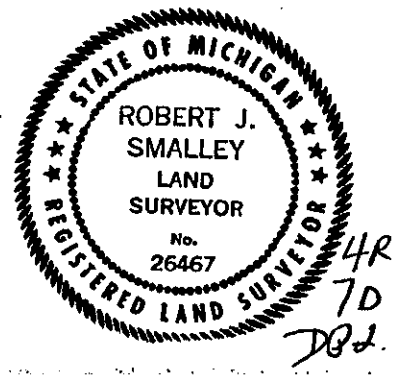

95268809