

APR 05 1996

LAND CORNER RECORDATION CERTIFICATE
Filing requirement of Act 74, Mich. P.A. 1970

COMMISSION

For corners in WAYNE COUNTY Located In: LIVONIA Corner Code # _____
(County)

- | | | | | | |
|------------------------------------|---|------------|---|------------|--------------|
| 1. Public Land Survey | T | <u>1 S</u> | R | <u>9 E</u> | <u>M - 4</u> |
| | T | _____ | R | _____ | _____ |
| | T | _____ | R | _____ | _____ |
| | T | _____ | R | _____ | _____ |
| 2. Property Controlling in Section | S | _____ | R | _____ | _____ |
| | S | _____ | R | _____ | _____ |
| 3. Miscellaneous Property in Sec. | S | _____ | R | _____ | _____ |
| | S | _____ | R | _____ | _____ |
4. Lot No. _____, Recorded Plat _____
5. Private Claims _____

LIBER **28465** PAGE **794**

Compliance with ACT 345, P.A. 1990

APPROVED ON: 12-13-95
WAYNE COUNTY REMONUMENTATION PEER GROUP COMMITTEE

Register of Deeds Stamp & File Number

	A	B	C	D	E	F	G	H	I	J	K	L	M
1													
2	6	5	4	3	2	1							
3													
4	7	8	9	10	11	12							
5													
6	18	17	16	15	14	13							
7													
8	19	20	21	22	23	24							
9													
10	30	29	28	27	26	25							
11													
12	31	32	33	34	35	36							
13													

I, ROBERT J. SMALLEY, in a field survey on NOVEMBER 13, 1995, do hereby certify that under requirements of P.A. 74, Michigan P.A. of 1970, the corner points mentioned in lines 1 and 2 above were in conformance with regulations and rules therefore as required in the current manual of survey instructions of the United States Department of the Interior, Bureau of Land Management or by a decree of a Court of Law and/or that the cornerpoints mentioned in lines 3, 4 and 5 above were in conformance with the rules of the Michigan Board of Land Surveyors or by a Decree of a Court of Law; re-established, monumented, re-monumented, recovered, found as expressed below:

NOTE: Not more than 4 corners, all in the same town and range, may be recorded on this certificate.

A. Description of original monument and accessories and/or subsequent restoration:

GLO (1816): "POST"
WPA SURVEY (1930'S) "FOUND IRON REPLACED WITH MONUMENT"

\$ 4.00 REMONUMENTATION
\$ 7.00 DEED
15 DEC 95 11:22 A.M. RECEI A
RECORDED
FOREST E. YOUNGBLOOD, REGISTER EDS
WAYNE COUNTY, MI

B. Description of corner evidence found and/or method applied in restoring or reestablishing corner:

FOUND CONCRETE MONUMENT (WITH 1/2" BAR) IN MONUMENT BOX AT THE INTERSECTION OF INKSTER ROAD AND VACATED CURTIS AVE. CHECKED DISTANCE TO M-3, M-5 AND A-4 (REDFORD TWP.) AGAINST DISTANCES MEASURED BY WPA SURVEY AS FOLLOWS:

M-3 to M-4 -	S 0°17'20" W,	2648.53'	(MEAS. 2649.05')
M-4 to M-5 -	S 0°17'25" W,	2632.92'	(MEAS. 2632.84')
M-4 to A-4 (REDFORD)	NORTH	33.38'	(MEAS. 33.72')

NOTE: THIS CORNER IS NOT COMMON WITH CORNER A-4 OF REDFORD TOWNSHIP, T. 1 S., R. 10 E.


C. Description of monument for corner and accessories to perpetuate locating the position of the corner:

FOUND CONCRETE MONUMENT (WITH 1/2" BAR) IN MONUMENT BOX AT THE INTERSECTION OF INKSTER ROAD AND VACATED CURTIS AVE. (NEW MONUMENT BOX SET IN ASPHALT PAVEMENT); SET "WAYNE COUNTY REMONUMENTATION" TAG & SURVEY CAP NO. "30086-26467" OVER IRON BAR IN MONUMENT.

NORTH 33.72'; FOUND CONCRETE MONUMENT IN MONUMENT BOX AT CORNER A-4 (REDFORD)
S. 86° E. 40.97'; FOUND PK NAIL AND WCRC TAG IN NORTH FACE OF UTILITY POLE.
S. 64° E. 55.24'; CENTER OF WORKING NUT ON FIRE HYDRANT.
S. 88° W. 52.14'; FOUND PK NAIL AND WCRC TAG IN SOUTH FACE OF UTILITY POLE.
N. 53° W. 52.95'; CUT "X" IN SW BOLT OF CONCRETE LIGHT POLE BASE.

THE SELECTED LOCATION IS ACCEPTED BY THE CONTRACTOR AND IS GENERALLY ACCEPTED BY PROFESSIONAL SURVEYORS AS THE BEST AVAILABLE EVIDENCE OF THE ORIGINAL CORNER

Signed by Robert J. Smalley Date Dec 13, 1995
ROBERT J. SMALLEY
Surveyor's Michigan License No. 26467

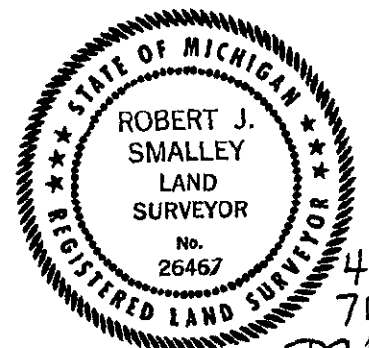

95268810