

APR 05 1996
COMMISSION

LAND CORNER RECORDATION CERTIFICATE
Filing requirement of Act 74, Mich. P.A. 1970

For corners in WAYNE COUNTY Located in: LIVONIA Corner Code # _____
(County)

- | | | | | | |
|------------------------------------|---|------------|---|------------|---------------|
| 1. Public Land Survey | T | <u>1 S</u> | R | <u>9 E</u> | <u>M - 10</u> |
| | T | _____ | R | _____ | _____ |
| | T | _____ | R | _____ | _____ |
| | T | _____ | R | _____ | _____ |
| 2. Property Controlling in Section | S | _____ | R | _____ | _____ |
| | S | _____ | R | _____ | _____ |
| 3. Miscellaneous Property in Sec. | S | _____ | R | _____ | _____ |
| | S | _____ | R | _____ | _____ |
4. Lot No. _____, Recorded Plat _____
5. Private Claims _____

LIBER 28465 PAGE 795

Compliance with
ACT 345, P.A. 1990
APPROVED ON: 12-13-95 *DPJ*
WAYNE COUNTY REMONUMENTATION
PEER GROUP COMMITTEE
Register of Deeds Stamp & File Number

I, ROBERT J. SMALLEY, in a field survey on MARCH 23, 19 95, do hereby certify that under requirements of P.A. 74, Michigan P.A. of 1970, the corner points mentioned in lines 1 and 2 above were in conformance with regulations and rules therefore as required in the current manual of survey instructions of the United States Department of the Interior, Bureau of Land Management or by a decree of a Court of Law and/or that the cornerpoints mentioned in lines 3, 4 and 5 above were in conformance with the rules of the Michigan Board of Land Surveyors or by a Decree of a Court of Law; re-established, monumented, re-monumented, recovered, found as expressed below:

NOTE: Not more than 4 corners, all in the same town and range, may be recorded on this certificate.

1	A	B	C	D	E	F	G	H	I	J	K	L	M
2	6	5	4	3	2	1							
3													
4	7	8	9	10	11	12							
5													
6	18	17	16	15	14	13							
7													
8	19	20	21	22	23	24							
9													
10	30	29	28	27	26	25							
11													
12	31	32	33	34	35	36							
13													

A. Description of original monument and accessories and/or subsequent restoration:
GLO (1816): "POST"
WPA SURVEY (1930'S) "CROSS"

\$ 4.00 REMONUMENTATION
\$ 7.00 DEED
15 DEC 95 11:23 A.M. RECEI A
RECORDED
FOREST E. YOUNGBLOOD, REGISTER EDS
WAYNE COUNTY, MI

B. Description of corner evidence found and/or method applied in restoring or reestablishing corner:
FOUND 1/2 " BAR IN MONUMENT BOX AT THE INTERSECTION OF INKSTER ROAD AND THE C&O RAILROAD. CHECKED DISTANCE TO M-9, M-11 AND A FOUND MONUMENT AT THE SOUTH LINE OF THE RAILROAD AGAINST DISTANCES MEASURED BY WPA SURVEY AS FOLLOWS:


M-9 to M-10 -	S 0°26'50" W,	2537.17	(MEAS. 2537.36')
M-10 to M-11 -	S 0°29'40" W,	2725.32'	(MEAS. 2724.71')
M-10 to MONUMENT		49.50'	(MEAS. 49.30')

NOTE: THIS CORNER IS COMMON WITH CORNER A-10 OF REDFORD TOWNSHIP, T. 1 S., R. 10 E.

C. Description of monument for corner and accessories to perpetuate locating the position of the corner:
FOUND 1/2" BAR IN MONUMENT BOX AT THE INTERSECTION OF INKSTER ROAD AND THE C&O RAILROAD ; SET "WAYNE COUNTY REMONUMENTATION" TAG & SURVEY CAP NO. "30086-26467" OVER IRON BAR.
SOUTH 49.30'; FOUND CONCRETE MONUMENT IN MONUMENT BOX.
N. 44° E. 74.20'; SET PK NAIL AND "WCR WITNESS" TAG IN SE FACE OF UTILITY POLE.
S. 36° E. 89.11'; SET PK NAIL AND "WCR WITNESS" TAG IN WEST FACE OF UTILITY POLE.
S. 88° W. 52.14'; SET PK NAIL AND "WCR WITNESS" TAG IN SE FACE OF UTILITY POLE.
N. 46° W. 43.19'; CENTER OF SW BOLT OF CONCRETE BASE OF RAILROAD SIGNAL.

THE SELECTED LOCATION IS ACCEPTED BY THE CONTRACTOR AND IS GENERALLY ACCEPTED BY PROFESSIONAL SURVEYORS AS THE BEST AVAILABLE EVIDENCE OF THE ORIGINAL CORNER

Signed by Robert J. Smalley Date Dec. 13, 1995
ROBERT J. SMALLEY
Surveyor's Michigan License No. 26467

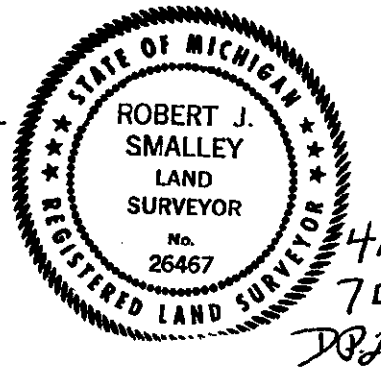

95268811