SURVEY & REMONUMENTATION

RC 1484

APR 2 5 1995

COMMISSION

LAND CORNER RECORDATION CERTIFICATE

Filing requirement of Act 74, Mich. P.A. 1970 L127796PA712

For corners in **WAYNE COUNTY** (County) Located In: Corner Code #

1. Public Land Survey		T 1 S	R 9 E	M - 11
		T	R	
		T	R	
		T	R	
2. Property Controlling	S	T	R	
in Section	S	T	R	
3. Miscellaneous	S	T	R	
Property in Sec.	S	T	R	

Compliance with ACT 345, P.A. 1990

APPROVED ON: 12-12-94

WAYNE COUNTY REMONUMENTATION PEER GROUP COMMITTEE

Register of Deeds Stamp & File Number

4. Lot No. _____, Recorded Plat _____
5. Private Claims _____

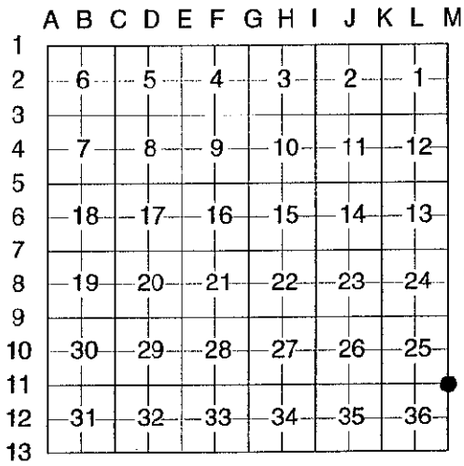

I, **ROBERT J. SMALLEY**, in a field survey on **DECEMBER 16**, 19 **94**, do hereby certify that under requirements of P.A. 74, Michigan P.A. of 1970, the corner points mentioned in lines 1 and 2 above were in conformance with regulations and rules therefore as required in the current manual of survey instructions of the United States Department of the Interior, Bureau of Land Management or by a decree of a Court of Law and/or that the cornerpoints mentioned in lines 3, 4 and 5 above were in conformance with the rules of the Michigan Board of Land Surveyors or by a Decree of a Court of Law; re-established, monumented, re-monumented, recovered, found as expressed below:

NOTE: Not more than 4 corners, all in the same town and range, may be recorded on this certificate.

A. Description of original monument and accessories and/or subsequent restoration:

GLO (1816): "POST"
WPA(1930'S): "MONUMENT"

$ 13.00 MISCELLANEOUS RECORDING
22 DEC 94 3:41 P.M. RECEIPT# 93A
RECORDED
FOREST E. YOUNGBLOOD, REGISTER OF DEEDS
WAYNE COUNTY, MI

B. Description of corner evidence found and/or method applied in restoring or reestablishing corner:

FOUND CONCRETE MONUMENT (WITH 3/4" IRON BAR) IN MONUMENT BOX AT THE INTERSECTION OF INKSTER ROAD AND PLYMOUTH ROAD. CHECKED DISTANCE FROM M-11 TO M-12, M-11 TO K-11 AND M-11 TO A-11 (REDFORD) AGAINST DISTANCES MEASURED BY WPA SURVEY OF 1930'S AS FOLLOWS:

M-11 TO M-12	**WPA 2645.09'**		**(MEAS. 2645.12')**
M-11 TO K-11	**WPA SEC 25 5302.15'**	**WPA SEC 36 5302.69'**	**(MEAS. 5302.51')**
M-11 TO A-11 (REDFORD)	**WPA 125.71'**		**(MEAS. 125.70')**

C. Description of monument for corner and accessories to perpetuate locating the position of the corner:

FOUND CONCRETE MONUMENT (WITH 3/4" IRON BAR) IN MONUMENT BOX AT THE INTERSECTION OF INKSTER ROAD AND PLYMOUTH ROAD; SET "WAYNE COUNTY REMONUMENTATION" TAG AND SURVEY CAP No. "30086-26467" OVER BAR IN MONUMENT.

NORTH	**125.70'**	**FOUND CONCRETE MONUMENT (WITH 3/4" IRON BAR) IN MONUMENT BOX AT OR NEAR CORNER A-11 (REDFORD).**
N. 56° E.	**72.54';**	**SET NAIL AND "WCR WITNESS" TAG IN NORTHWEST FACE OF UTILITY POLE** 2R
S. 26° E.	**84.10';**	**SET NAIL AND "WCR WITNESS" TAG IN SOUTHWEST FACE OF UTILITY POLE** 11D
S. 20° W.	**123.73'**	**SET NAIL AND "WCR WITNESS" TAG IN SOUTHEAST FACE OF UTILITY POLE**
S. 80° W.	**45.41';**	**SET NAIL AND "WCR WITNESS" TAG IN SOUTH FACE OF UTILITY POLE** MISC

THE SELECTED LOCATION IS ACCEPTED BY THE CONTRACTOR AND IS GENERALLY ACCEPTED BY PROFESSIONAL SURVEYORS AS THE BEST AVAILABLE EVIDENCE OF THE ORIGINAL CORNER.

STATE OF MICHIGAN
ROBERT J. SMALLEY
LAND SURVEYOR
No. 26467
REGISTERED LAND SURVEYOR

Signed by Robert J. Smalley Date 12-22-94
ROBERT J. SMALLEY

Surveyor's Michigan License No. 26467