

FEB 2 1994

CORNER RECORDATION

RC 1235

LAND CORNER RECORDATION CERTIFICATE  
Filing Requirement of Act 74, Mich. P.A. 1970

LI 27015 PA 710

For corners in

<u>Wayne</u> (County)	Located In:	Corner Code #
1. Public Land Survey	T <u>1</u> S. R <u>10</u> E.	<u>A-8</u>
	T _____ R _____	_____
	T _____ R _____	_____
	T _____ R _____	_____
2. Property Controlling in Section	S _____ T _____ R _____	_____
	S _____ T _____ R _____	_____
3. Miscellaneous Property in Sec.	S _____ T _____ R _____	_____
	S _____ T _____ R _____	_____
4. Lot No. _____, Recorded Plat _____		
5. Private Claims _____		

Compliance with  
ACT 345, P.A. 1990  
APPROVED ON: 12-7-93 *DP*  
WAYNE COUNTY REMONUMENTATION  
PEER GROUP COMMITTEE

Register of Deeds Stamp & File Number

RC 1235

I, William L. Roskelly in a field survey on October 28, 19 93, do hereby certify that under requirements of P.A. 74, Michigan P.A. of 1970, the corner points mentioned in lines 1 and 2 above were in conformance with regulations and rules therefore as required in the current manual of survey instructions of the United States Department of the Interior, Bureau of Land Management or by a decree of a Court of Law and/or that the corner points mentioned in lines 3, 4 and 5 above were in conformance with the rules of the Michigan Board of Land Surveyors or by a Decree of a Court of Law; established, re-established, monumented, re-monumented, recovered, found as expressed below:

NOTE: Not more than 4 corners, all in the same town and range, may be recorded on this certificate.

A	B	C	D	E	F	G	H	I	J	K	L	M
2	6	5	4	3	2	1						
3												
4	7	8	9	10	11	12						
5												
6	16	17	16	15	14	13						
7												
8	19	20	21	22	23	24						
9												
10	30	29	28	27	26	25						
11												
12	31	32	33	34	35	36						
13												


A. Description of original monument and accessories and/or subsequent restoration:  
No G.L.D. witnesses remain.  
L.C.R.C. L. 19315 P. 782 & 783 on November 18, 1975 R.W. Swanson found a concrete monument in mon. box and set the following witnesses:  
N.E. 73.73 ft. to horizontal spike with brass tag in S.E. side of D.E. pole.  
S.E. 81.65 ft. to horizontal spike with brass tag in N.E. side of D.E. pole.  
S. 44.75 ft. to concrete monument in box at the East 1/4 cor. section 24, T.1S.R.9E.  
S.W. 75.18 ft. to horizontal spike with brass tag in N. side of D.E. pole

B. Description of corner evidence found and/or method applied in restoring or reestablishing corner:  
Also verified section corner thru documents L. 19315, P.782 & 783  
N.E. 73.73 tag S.E. face P. pole measured 73.71  
S.E. 81.65 tag N.E. face P. pole measured 81.65  
S. 44.75 conc. mon. in box E. 1/4 corner Sec. 24, T.1 S.R.9 E. measured 44.75  
S.W. 75.18 tag N. face p. pole measured 75.17  
Found iron pipe in concrete monument in mon. box

C. Description of monument for corner and accessories established to perpetuate locating the position of the corner:  
A-8: Section corner 19 T.1 S. R.10 E. Found iron pipe in concrete monument in mon. box. The selected location is accepted by the Contractor and is generally accepted by professional surveyors as the best available evidence of the position of the original corner. Placed Wayne Co. brass disk with license #10705.  
P.K. tag 10705, S.E. face P. pole N. 54° E. distance 73.95 set.  
Set P.K. tag 10705 N.E. face p. pole S. 30° E. distance 81.75.  
Mon. box conc. mon. iron pipe due south distance 44.75.  
Assumed to be E. 1/4 corner sec. 24, T.1 S. R.9E. Livonia.  
Set P.K. tag 10705 N. face p. pole S. 70° W. distance 75.17.

Signed by William L. Roskelly  
Surveyor's Michigan License No. 10705

Date November 9, 1993

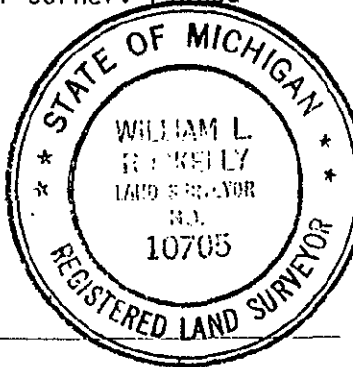

2R 11KD