

RC 1237

LAND CORNER RECORDATION CERTIFICATE LI 27015 PA 712  
Filing Requirement of Act 74, Mich. P.A. 1970

For corners in

Wayne (County)	Located In:	Corner Code #
1. Public Land Survey	T 15. R 10 E.	B-3
	T _____ R _____	_____
	T _____ R _____	_____
	T _____ R _____	_____
2. Property Controlling in Section	S _____ T _____ R _____	_____
	S _____ T _____ R _____	_____
3. Miscellaneous Property in Sec.	S _____ T _____ R _____	_____
	S _____ T _____ R _____	_____
4. Lot No. _____, Recorded Plat _____		
5. Private Claims _____		

Compliance with  
ACT 345, P.A. 1990  
APPROVED ON: 12-7-93  
WAYNE COUNTY REMONUMENTATION  
PEER GROUP COMMITTEE  
Register of Deeds Stamp & File Number

I, William L. Roskelly, in a field survey on October 27, 19 93, do hereby certify that under requirements of P.A. 74, Michigan P.A. of 1970, the corner points mentioned in lines 1 and 2 above were in conformance with regulations and rules therefore as required in the current manual of survey instructions of the United States Department of the Interior, Bureau of Land Management or by a decree of a Court of Law and/or that the corner points mentioned in lines 3, 4 and 5 above were in conformance with the rules of the Michigan Board of Land Surveyors or by a Decree of a Court of Law; established, re-established, monumented, re-monumented, recovered, found as expressed below:

NOTE: Not more than 4 corners, all in the same town and range, may be recorded on this certificate.

	A	B	C	D	E	F	G	H	I	J	K	L	M
2		6		5		4		3		2		1	
3		7		8		9		10		11		12	
4		13		14		15		16		17		18	
5		19		20		21		22		23		24	
6		25		26		27		28		29		30	
7		31		32		33		34		35		36	
8													
9													
10													
11													
12													
13													

A. Description of original monument and accessories and/or subsequent restoration:

No G.L.O. witnesses remain. Joseph Fletcher G.L.O. ser corner post May 14, 1814.  
W.P.A. (1930's) iron set. Witnesses:  
12" Maple N.W. 65.4 ft. (gone)  
Pole N.E. 49.00 (gone)  
8" Elm S.W. 53.50 (gone)  
8" Elm S.E. 60.50 (gone)


B. Description of corner evidence found and/or method applied in restoring or reestablishing corner:

Found steel bar in concrete monument in mon. box at the intersection of 7 Mile and Delaware Road.  
Measured distance for comparison to W.P.A. record.  
Distance B-3 to C-3 W.P.A. = 2624.26 measured = 2623.84  
Distance C-3 to C-4 W.P.A. = 2620.20 measured = 2620.16  
Angle C-3/B-3 to C-3/C-4 W.P.A. = 89° 03' 30" measured = 89° 03' 20"

C. Description of monument for corner and accessories established to perpetuate locating the position of the corner:

B-3" Section corner 6 & 7 T.1 S.R.10 E. found steel bar in concrete monument in mon. box. The selected location is accepted by the Contractor and is generally accepted by professional surveyors as the best available evidence of the position of the original corner. Placed Wayne Co. brass disk with license #10705.  
Found W.C.R.C. Tag & PK nail E. face P. pole due North dist. 34.24  
Set WCR Tag & nail W. face Guy pole N. 80° E. dist. 70.75  
Set WCR Tag & nail N. face light pole S. 66° E. dist. 136.53  
Found WCRC Tag & PK S.E. face P. pole S. 44° W. dist. 52.54

RECORDED - 7 PM 2:10

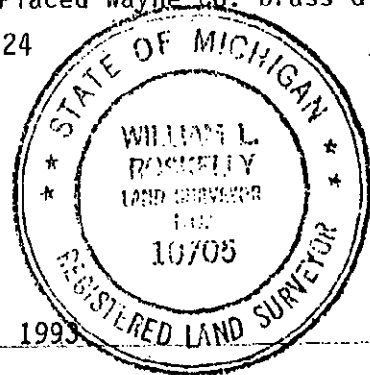

Signed by William L. Roskelly  
Surveyor's Michigan License No. 10705

Date November 9, 1993

2R 11K1