

RC 1238

LAND CORNER RECORDATION CERTIFICATE
Filing Requirement of Act 74, Mich. P.A. 1970

LI 27015 PA 713

For corners in
Wayne
(County)

Located In: Corner Code ##

- 1. Public Land Survey T 1 S. R. 10 E. C-3
 T _____ R _____
 T _____ R _____
 T _____ R _____
- 2. Property Controlling S _____ T _____ R _____
 in Section S _____ T _____ R _____
- 3. Miscellaneous S _____ T _____ R _____
 Property in Sec. S _____ T _____ R _____
- 4. Lot No. _____, Recorded Plat _____
- 5. Private Claims _____

Compliance with
ACT 345, P.A. 1990

APPROVED ON: 12-7-93 *DPF*
WAYNE COUNTY REMONUMENTATION
PEER GROUP COMMITTEE

Register of Deeds Stamp & File Number

RC 1238

	A	B	C	D	E	F	G	H	I	J	K	L	M
2	6		5		4		3		2		1		
3		●											
4	7		8		9		10		11		12		
5													
6	18		17		16		15		14		13		
7													
8	19		20		21		22		23		24		
9													
10	30		29		28		27		26		25		
11													
12	31		32		33		34		35		36		
13													

I, William L. Roskelly in a field survey on October 27, 1993, do hereby certify that under requirements of P.A. 74, Michigan P.A. of 1970, the corner points mentioned in lines 1 and 2 above were in conformance with regulations and rules therefore as required in the current manual of survey instructions of the United States Department of the Interior, Bureau of Land Management or by a decree of a Court of Law and/or that the corner points mentioned in lines 3, 4 and 5 above were in conformance with the rules of the Michigan Board of Land Surveyors or by a Decree of a Court of Law; established, re-established, monumented, re-monumented, recovered, found as expressed below:

NOTE: Not more than 4 corners, all in the same town and range, may be recorded on this certificate.

A. Description of original monument and accessories and/or subsequent restoration:

No G.L.O. witnesses remain
Joseph Fletcher G.L.O. set corner and witnessed: Beech 12N 58W 10 Do 10N 10W 44

B. Description of corner evidence found and/or method applied in restoring or reestablishing corner:

Found steel bar in concrete monument in mon. box at the intersection of 7 Mile and Beech Daly Roads.

Measured distances to compare with W.P.A. records:
From C-3 to B-3 W.P.A. = 2624.26 measured = 2623.84
From C-3 to C-4 W.P.A. = 2620.20 measured = 2620.16
Turned angle C-3/B-3 to C-3/C-4 W.P.A. = 89° 03' 30" measured = 89° 03' 20"

C. Description of monument for corner and accessories established to perpetuate locating the position of the corner:


C-3: Section corner 6,5,8 & 7 T.1 S.R.10 E., found steel bar in concrete monument in mon. box. The selected location is accepted by the Contractor and is generally accepted by professional surveyors as the best available evidence of the position of the original corner.

Placed Wayne Co. brass disk with license #10705.

- Found W.C.R.C. Tag N.W. face P. pole N. 48° E. dist. 65.27
- Found W.C.R.C. Tag S.W. face P. pole S. 50° E. dist. 78.26
- Set WCR Tag N.W. face Light pole S. 46°W. dist. 73.45
- Set WCR Tag S.W. face signal pole N. 45° W. dist. 68.36

Signed by William L. Roskelly
Surveyor's Michigan License No. 10705

Date November 1993

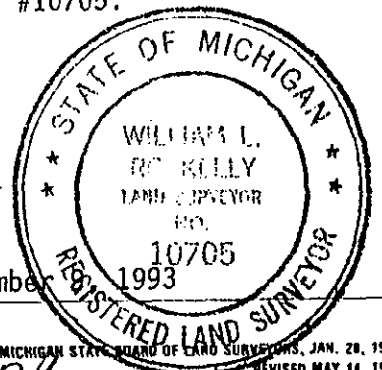

26
HKD

RECORDED
INDEXED
NOV 10 1993
12:10 PM '93