

FEB 28 1993

RC 1239

LI 27015 PA 714

LAND CORNER RECORDATION CERTIFICATE
Filing Requirement of Act 74, Mich. P.A. 1970

For corners in

<u>Wayne</u> (County)	Located in:	Corner Code #
1. Public Land Survey	T <u>1</u> S <u>R</u> <u>10</u> E. <u>C-7</u>	
	T _____ R _____	
	T _____ R _____	
	T _____ R _____	
2. Property Controlling in Section	S _____ T _____ R _____	
	S _____ T _____ R _____	
3. Miscellaneous Property in Sec.	S _____ T _____ R _____	
	S _____ T _____ R _____	
4. Lot No. _____, Recorded Plat _____		
5. Private Claims _____		

Compliance with
ACT 345, P.A. 1990
APPROVED ON: 12-7-93 *DPJ*
WAYNE COUNTY REMONUMENTATION
PEER GROUP COMMITTEE

Register of Deeds Stamp & File Number

I, William L. Roskelly in a field survey on October 28, 1993, do hereby certify that under requirements of P.A. 74, Michigan P.A. of 1970, the corner points mentioned in lines 1 and 2 above were in conformance with regulations and rules therefore as required in the current manual of survey instructions of the United States Department of the Interior, Bureau of Land Management or by a decree of a Court of Law and/or that the corner points mentioned in lines 3, 4 and 5 above were in conformance with the rules of the Michigan Board of Land Surveyors or by a Decree of a Court of Law; established, re-established, monumented, re-monumented, recovered, found as expressed below:

NOTE: Not more than 4 corners, all in the same town and range, may be recorded on this certificate.

A. Description of original monument and accessories and/or subsequent restoration:


No G.L.O. witnesses remain
Joseph Fletcher G.L.O. (1814) Witnesses listed: Beech 12 N73E 30 Do 9S28E 30
W.P.A. set iron and recorded the following witnesses:
Stake N.W. 73.5 (gone)
Stake N.E. 75.0 (gone)
Fence S.W. 76.0 (gone)
Stake S.E. 75.0 (gone)

B. Description of corner evidence found and/or method applied in restoring or reestablishing corner:

Found steel bar in monument box at the intersection of 5 Mile and Beech Daly Roads.
Measured distance to compare with W.P.A. records:
Distance C-7 to D-7 W.P.A. = 2624.39 measured = 2624.83

C. Description of monument for corner and accessories established to perpetuate locating the position of the corner:

C-7: Section corner 17,17,19 & 20 T.1 S.R.10 E., found steel bar in monument box. The selected location is accepted by the Contractor and is generally accepted by professional surveyors as the best available evidence of the position of the original corner. Placed Wayne Co. brass disk with license #10705.
Set WCR Tag West face P. pole N. 34° E. dist. 75.44
Set WCR Tag S.W. face P. pole S. 40° E. dist. 59.18
Set WCR Tag S.E. face P. pole S. 40° W. dist. 66.23
Set WCR Tag N.E. face P. pole N. 40° W. dist. 58.45

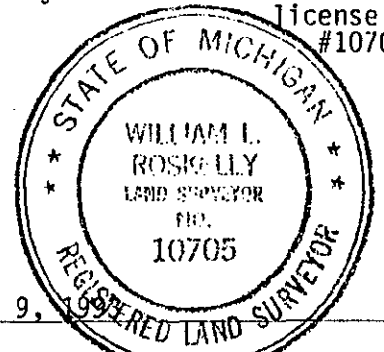

Signed by *William L. Roskelly* Date November 9, 1993
Surveyor's Michigan License No. 10705

22 11K1