

RC 1240

LAND CORNER RECORDATION CERTIFICATE  
Filing Requirement of Act 74, Mich. P.A. 1970

127015 PA 715

For corners in

Wayne <small>(County)</small>	Located In:	Corner Code #
1. Public Land Survey	T 1 S R 10 E.	C-11
	T _____ R _____	_____
	T _____ R _____	_____
2. Property Controlling in Section	S _____ T _____ R _____	_____
	S _____ T _____ R _____	_____
3. Miscellaneous Property in Sec.	S _____ T _____ R _____	_____
	S _____ T _____ R _____	_____
4. Lot No. _____, Recorded Plat _____		
5. Private Claims _____		

Compliance with  
ACT 345, P.A. 1990  
APPROVED ON: 12-7-93 *DoJ*  
WAYNE COUNTY REMONUMENTATION  
PEER GROUP COMMITTEE

Register of Deeds Stamp & File Number

RC 1240

I, William L. Roskelly in a field survey on October 28, 1993, do hereby certify that under requirements of P.A. 74, Michigan P.A. of 1970, the corner points mentioned in lines 1 and 2 above were in conformance with regulations and rules therefore as required in the current manual of survey instructions of the United States Department of the Interior, Bureau of Land Management or by a decree of a Court of Law and/or that the corner points mentioned in lines 3, 4 and 5 above were in conformance with the rules of the Michigan Board of Land Surveyors or by a Decree of a Court of Law; established, re-established, monumented, re-monumented, recovered, found as expressed below:

NOTE: Not more than 4 corners, all in the same town and range, may be recorded on this certificate.

	A	B	C	D	E	F	G	H	I	J	K	L	M
2	6		5		4		3		2		1		
3													
4	7		8		9		10		11		12		
5													
6	13		17		16		15		14		13		
7													
8	19		20		21		22		23		24		
9													
10	30		29		28		27		26		25		
11													
12	31		32		33		34		35		36		
13													

A. Description of original monument and accessories and/or subsequent restoration:

No G.L.O. witnesses remain  
Joseph Fletcher G.L.O. set corner and witnessed: Beech 6 S16 W5 Do 4 N9 E6

RECORDED  
127015 PA 715  
OCT 28 1993  
PM 2:10

B. Description of corner evidence found and/or method applied in restoring or reestablishing corner:

Found 1" Steel Bar in concrete monument in mon. box at the intersection of Plymouth and Beech Daly Roads.  
Note: Double monumentation. Also found mon. box 1" Steel Bar at Plymouth & Beech Daly Roads-not section corner.

1. Set WCR Tag S.E. face P. pole N. 54° E. dist. 69.44; 2. Found MSHD Tag S.W. face P.pole S. 44° E. dist. 65.84; 3. Set WCR Tag N.W. face P.pole S. 44° W. dist. 72.07; 4. Set WCR Tag N.E. face P. pole N. 30° W. dist. 63.98; 5. Found mon. box with 1" steel bar in conc. S. 5° W. dist. 4.50.

Measured distance to compare with W.P.A. records:


Distance from C-11 to D-11: W.P.A. = 2629.49 measured 2629.69  
Angle C-11/D-11 to C-11/C-12 W.P.A. = 90°08'40" measured 90°08'20"  
Distance from C-11 to C-12 W.P.A. = 2630.56 measured 2630.58  
Angle C-11/C-12 to C-11/C-10 W.P.A. = 88°36'00" measured = 88° 37' 10"  
Distance from C-11 to C-10 W.P.A. = 2595.66 measured = 2596.06  
Angle C-11/C-10 to C-11/D-11 W.P.A. = 181° 15' 20" measured = 181° 14' 30"

C. Description of monument for corner and accessories established to perpetuate locating the position of the corner:

C-11: Section corner 29,30,31 & 32 T.1 S.R.10 E., found 1" steel bar in concrete monument in mon. box. The selected location is accepted by the Contractor and is generally accepted by professional surveyors as the best available evidence of the position of the original corner.

Placed Wayne Co. brass disk with license #10705.

Set WCR Tag S.E. face P. pole N. 54° E. dist. 73.94  
Found MSHD Tag S.W. face P. pole S. 44° E. dist. 66.30  
Set WCR Tag N.W. face P. pole S. 44° W. dist. 67.63  
Set WCR Tag N.E. face P. pole N. 30° W. dist. 63.55  
Found mon. box with 1" steel bar in conc. N. 5° E. dist. 4.50

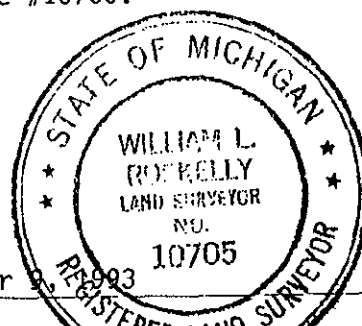

Signed by *William L. Roskelly*

Date November 9, 1993

Surveyor's Michigan License No. 10705

22 HKD