

RC 1241

LAND CORNER RECORDATION CERTIFICATE
Filing Requirement of Act 74, Mich. P.A. 1970

LI 27015 PA 716

For corners in

Wayne

(County)

Located In:

Corner Code #/

- 1. Public Land Survey T 1 S. R 10 E. C-12
T _____ R _____
T _____ R _____
T _____ R _____
- 2. Property Controlling S _____ T _____ R _____
in Section S _____ T _____ R _____
- 3. Miscellaneous S _____ T _____ R _____
Property in Sec. S _____ T _____ R _____
- 4. Lot No. _____, Recorded Plat _____
- 5. Private Claims _____

Compliance with
ACT 345, P.A. 1990
APPROVED ON: 12-7-93 *Doc.*
WAYNE COUNTY REMONUMENTATION
PEER GROUP COMMITTEE

Register of Deeds Stamp & File Number

I, William L. Roskelly in a field survey on October 28, 1993, do hereby certify that under requirements of P.A. 74, Michigan P.A. of 1970, the corner points mentioned in lines 1 and 2 above were in conformance with regulations and rules therefore as required in the current manual of survey instructions of the United States Department of the Interior, Bureau of Land Management or by a decree of a Court of Law and/or that the corner points mentioned in lines 3, 4 and 5 above were in conformance with the rules of the Michigan Board of Land Surveyors or by a Decree of a Court of Law; established, re-established, monumented, re-monumented, recovered, found as expressed below:

NOTE: Not more than 4 corners, all in the same town and range, may be recorded on this certificate.

A. Description of original monument and accessories and/or subsequent restoration:

No G.L.O. witnesses remain

R. W. Swanson on September 21, 1977 LCRC L. 20279, P. 378 reported finding a concrete monument in mon. box and set the following witnesses:

N.N.E. 67.95 ft. to nail with brass tag in N.W. side of Detroit Edison Pole.

E.N.E. 78.35 ft. to centerline top of fire hydrant.

S.E. 73.95 ft. to face of corner fence post.

S.W. 70.48 ft. to nail with metal washers in S.E. side of Detroit Edison Pole

B. Description of corner evidence found and/or method applied in restoring or reestablishing corner:

Found steel bar in concrete monument in mon. box at the intersection of West Chicago and Beech Daly Roads.

Also verified section corner thru document L. 20279, Pg. 378,379

N.N.E. 67.95 ft. see witness #1 below M = 67.92


E.N.E. 78.35 ft. see witness #2 below M = 78.38

S.E. 73.95 fence M = 73.70± bent

C. Description of monument for corner and accessories established to perpetuate locating the position of the corner:

C-12: Section corner 31 & 32 T.1 S.R.10 E., found steel bar in concrete monument in mon. box The selected location is accepted by the Contractor and is generally accepted by professional surveyors as the best available evidence of the position of the original corner found Wayne Co.

- Found Tag N.W. face P. pole N. 50° E. dist. 67.92
- Top bolt of hydrant N. 80° E. dist. 78.38
- Center key hole watergate S. 35° E. dist. 66.60
- Set WCR Tag N.W. face P. pole S. 50° W. dist. 70.00
- Set WCR Tag E. face Guy pole N. 20° W. dist. 99.63

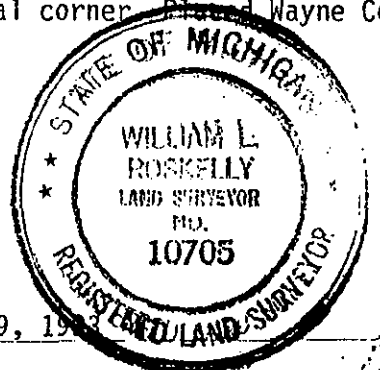

Signed by

William L. Roskelly

Date November 9, 1993

Surveyor's Michigan License No. 10705

2K 11KD

RC 1241

NOV 10 1993