

L129867PA028

LAND CORNER RECORDATION CERTIFICATE
Filing Requirement of Act 74, Mich. P.A. 1970

For corners in

Wayne, Redford Twp.
(County)

Located In:

Corner Code #

- 1. Public Land Survey T 1S. R 10E D-3
 T R
 T R
 T R
- 2. Property Controlling S T R
 in Section S T R
- 3. Miscellaneous S T R
 Property in Sec. S T R

Compliance with
ACT 345, P.A. 1990

APPROVED ON: 12-18-96 *JG*


WAYNE COUNTY REMONUMENTATION
PEER GROUP COMMITTEE

Register of Deeds Stamp & File Number

- 4. Lot No. _____, Recorded Plat _____
- 5. Private Claims _____

I, William L. Roskelly, in a field survey on Dec 10, 19 96 do hereby state that under requirements of P.A. 74, Michigan P.A. of 1970, the corner points mentioned in lines 1 and 2 above were in conformance with regulations and rules therefore as required in the current manual of survey instructions of the United States Department of the Interior, Bureau of Land Management or by a decree of a Court of Law and/or that the corner points mentioned in lines 3, 4 and 5 above were in conformance with the rules of the Michigan Board of Land Surveyors or by a Decree of a Court of Law; established, re-established, monumented, recovered, found as expressed below:

NOTE: Not more than 2 corners, all in the same town and range, may be recorded on this certificate.

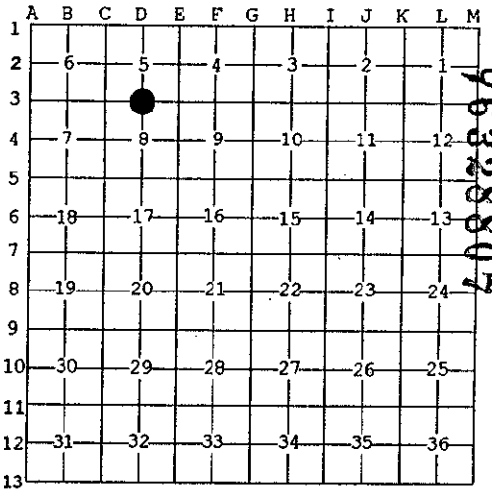

A. Description of original monument and accessories and/or subsequent restoration:

D-3) South corner section 5, T.1 S., R.10 E., Redford Township
 G.L.O. (1830's) Joseph Fletcher set corner post, witnesses: Beech 12N58 W10 (gone), Do 10N10 W44 (gone)
 W.P.A. (1930's) No witnesses.
 No RC's or CS's found on file at Wayne County.


\$ 4.00 REMONUMENTATION
 30 DEC 96 1:47 P.M. RECEIPT# ~~458~~
 RECORDED
 FOREST E. YOUNGBLOOD, REGISTER OF DEEDS
 WAYNE COUNTY, MI
 \$ 7.00 DEED

B. Description of corner evidence found and/or method applied in restoring or reestablishing corner:

D-3) South corner section 5, T.1 S., R.10 E., Redford Township
 Found a steel bar in concrete in a monument box at 7 Mile and 5 Points roads.
 Verified the corner location by comparing field measurements with W.P.A. survey and City of Detroit survey:
 Distance D-3 to C-3 Record = 2618.95', Measured = 2619.85'
 Distance D-3 to E-3 Record = 2648.40', Measured = 2647.54'
 Angle line D-3 & C-2 to D-3 & E-3 Record = 178° 41' 09", Measured = 178° 28' 33"

C. Description of monument for corner and accessories established to perpetuate locating the position of the corner:

D-3) South corner section 5, T.1 S., R.10 E., Redford Township
 Found a steel bar in concrete in a monument box at 7 Mile and 5 Points roads.
 WITNESSES: N. 14° E. 97.79' nail and WCR tag S.E. face guy pole,
 S. 27° W. 50.85' set nail and WCR tag W. face power pole,
 N. 81° W. 161.66' set WCR tag N. face power pole,
 N. 31° W. 74.53' set WCR tag S.W. face power pole.
 Placed Wayne County Remonumentation brass marker and cap #10705.

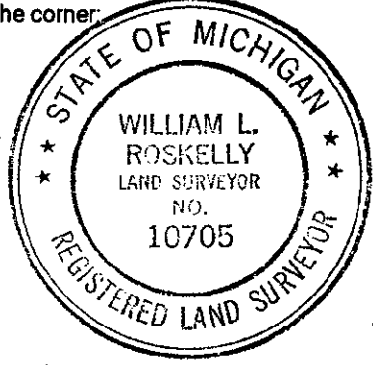

4R
7D
709

Signed by *William L. Roskelly*
 Surveyor's Michigan License No. 10705

Date 12-30-96