

SURVEY & REMONUMENTATION

RC 1556

APR 25 1995

LAND CORNER RECORDATION CERTIFICATE

\$ 13.00 MISCELLANEOUS RECORDING
 28 DEC 94 8:19 A.M. RECEIPT# 129
 RECORDED
 FOREST E. YOUNGBLOOD, REGISTER OF DEEDS
 WAYNE COUNTY, MI

COMMISSION

Filing Requirement of Act 74, Mich. P.A. 1970

For corners in

Wayne
(County)

Located In:

Corner Code #

- | | | | | | | | |
|------------------------------------|---|----------|---|---|-----------|---|-------------|
| 1. Public Land Survey | T | <u>1</u> | S | R | <u>10</u> | E | <u>D-13</u> |
| | T | | R | | | | |
| | T | | R | | | | |
| | T | | R | | | | |
| 2. Property Controlling in Section | S | | T | | R | | |
| | S | | T | | R | | |
| 3. Miscellaneous Property in Sec. | S | | T | | R | | |
| | S | | T | | R | | |

L127800PA047

Compliance with ACT 345, P.A. 1990

APPROVED ON: 12-8-94
 WAYNE COUNTY REMONUMENTATION PEER GROUP COMMITTEE

Register of Deeds Stamp & File Number

RC 1556

4. Lot No. _____ Recorded Plat _____
 5. Private Claims _____

	A	B	C	D	E	F	G	H	I	J	K	L	M
2	6		5		4		3		2		1		
3													
4	7		8		9		10		11		12		
5													
6	18		17		16		15		14		13		
7													
8	19		20		21		22		23		24		
9													
10	30		29		28		27		26		25		
11													
12	31		32		33		34		35		36		
13													

I, William L Roskelly, in a field survey on NOVEMBER December 22, 19 94, do hereby certify that under requirements of P.A. 74, Michigan P.A. of 1970, the corner points mentioned in lines 1 and 2 above were in conformance with regulations and rules therefore as required in the current manual of survey instructions of the United States Department of the Interior, Bureau of Land Management or by a decree of a Court of Law and/or that the corner points mentioned in lines 3, 4 and 5 above were in conformance with the rules of the Michigan Board of Land Surveyors or by a Decree of a Court of Law; established, re-established, monumented, re-monumented, recovered, found as expressed below:

NOTE: Not more than 4 corners, all in the same town and range, may be recorded on this certificate.

A. Description of original monument and accessories and/or subsequent restoration:
D-13) South Corner Section 32 T.1 S.,R.10 E.

G.L.O. (1830's) Joseph Fletcher set temporary corner post no witnesses in notes.
 W.P.A. (1930's) found iron witnesses: N.W. 74.23 2" Elm (gone), S.E. 68.80 3" Elm (gone), S.E. 82.30 iron (not found), E. 97.60 cross (gone), N. 32.42 2" Elm (gone).
 No R.C.'s or C.S.'s found on file at Wayne County Reg. of Deeds.


B. Description of corner evidence found and/or method applied in restoring or reestablishing corner:
D-13) South Corner Section 32 T.1 S.,R.10 E.

Found a steel bar in a concrete monument in a mon. box in the centerline of Joy Road. Verified corner location by comparing W.P.A. data with field measurements:
 D-13 to C-13 Record = 2620.48 Measured = 2620.81
 D-13 to E-13 Record = 2622.51 Measured = 2622.30
 D-13 90° 01' 10" E. to conc. mon. in mon. box Record = 97.60 Measured = 97.25
 D-13 270° 01' 27" W. to conc. mon. in mon. box Record = 2597.77 Measured = 2598.31
 Angle line D-13 & E-13 to line D-13 to C-13 Record = 179° 46' 20" Measured = 179° 46' 52"
 Found the following witnesses:
 Found P.K. nail S.W. face P. pole N.39° E. dist.= 76.71
 Found P.K. nail East face P. pole S.10° E. dist.= 29.64
 Found P.K. nail East face P. pole N.25° W. dist.= 70.19

C. Description of monument for corner and accessories established to perpetuate locating the position of the corner:
D-13) South Corner Section 32 T.1 S.,R.10 E.

Found a steel bar in a concrete monument in a mon. box in the centerline of Joy Road. The selected location is accepted by the Contractor and is generally accepted by professional surveyors as the best available evidence of the position of the original corner. Witnesses:
 Set nail & WCR tag S.W. face P. pole N.39° E. dist. = 76.71
 Set nail & WCR tag top wood fence post S.42° E. dist. = 81.58
 Set nail & WCR tag East face P. pole S.10° E. dist. = 29.66
 Set nail & WCR tag West face P. pole N.25° W. dist. = 70.18
 Found mon box conc. mon steel bar due East dist. = 97.25
 Placed Wayne County Remonumentation brass marker and cap #10705.

2R
 11-D
 MISC.

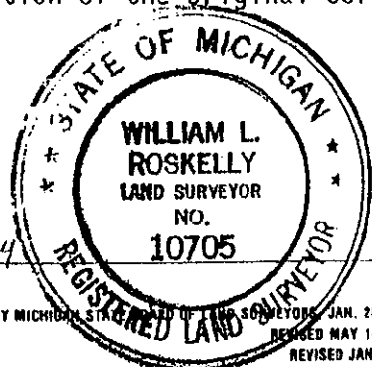

Signed by William L. Roskelly Date 12-12-94
 Surveyor's Michigan License No. 10705