

SURVEY & REMONUMENTATION

RC 1552
RC 1552

LI27800PA043

APR 25 1995

LAND CORNER RECORDATION CERTIFICATE

Filing Requirement of Act 74, Mich. P.A. 1970

\$ 13.00 MISCELLANEOUS RECORDING
28 DEC 94 8:18 A.M. RECEIPT# 120
RECORDED
FOREST E. YOUNGBLOOD, REGISTER OF DEEDS
WAYNE COUNTY, MI

For corners in **COMMISSION**

Wayne <small>(County)</small>	Located In:	Corner Code #
1. Public Land Survey	T <u>1</u> S R <u>10</u> E	<u>E-13</u>
	T _____ R _____	_____
	T _____ R _____	_____
	T _____ R _____	_____
2. Property Controlling in Section	S _____ T _____ R _____	_____
	S _____ T _____ R _____	_____
3. Miscellaneous Property in Sec.	S _____ T _____ R _____	_____
	S _____ T _____ R _____	_____
4. Lot No. _____, Recorded Plat _____		
5. Private Claims _____		

Compliance with ACT 345, P.A. 1990
APPROVED ON: 12-8-94 *DPJ*
WAYNE COUNTY REMONUMENTATION PEER GROUP COMMITTEE
Register of Deeds Stamp & File Number

RC 1552

I, William L Roskelly in a field survey on November 1, 19 94, do hereby certify that under requirements of P.A. 74, Michigan P.A. of 1970, the corner points mentioned in lines 1 and 2 above were in conformance with regulations and rules therefore as required in the current manual of survey instructions of the United States Department of the Interior, Bureau of Land Management or by a decree of a Court of Law and/or that the corner points mentioned in lines 3, 4 and 5 above were in conformance with the rules of the Michigan Board of Land Surveyors or by a Decree of a Court of Law; established, re-established, monumented, re-monumented, recovered, found as expressed below:

NOTE: Not more than 4 corners, all in the same town and range, may be recorded on this certificate.

A	B	C	D	E	F	G	H	I	J	K	L	M
2	6	5	4	3	2	1						
3												
4	7	8	9	10	11	12						
5												
6	16	17	16	15	14	13						
7												
8	19	20	21	22	23	24						
9												
10	30	29	28	27	26	25						
11												
12	31	32	33	34	35	36						
13												

A. Description of original monument and accessories and/or subsequent restoration:

E-13) South Corner Common to Sections 32 and 33 T.1 S.,R.10 E.

G.L.O. (1830's) Joseph Fletcher set corner, witnesses Beech 10 West 27 (gone), Gum 12 N.67 E.12 (gone).
W.P.A. (1930's) found an iron, witnesses: N.W. 73.8 monument (not found), N.W. 42.89 manhole (not found), S.W. 48.86 telephone pole (gone), S.E. 63.78 Edison pole (gone), E. 180.73 iron (not found), N.E. 44.28 12" Oak (gone).
No R.C.'s or C.S.'s found on file at Wayne County Reg. of Deeds.

B. Description of corner evidence found and/or method applied in restoring or reestablishing corner:

E-13) South Corner Common to Sections 32 and 33 T.1 S.,R.10 E.


Found a steel bar in concrete in mon. box at the intersection of Joy Road and South bound Telegraph Road. Verified corner location by comparing W.P.A. data with field measurements:
E-13 to E-12 Record = 2623.74 Measured = 2624.03 ±
E-13 to D-13 Record = 2622.51 Measured = 2622.30
Angle line E-13 & E-12 to line E-13 & D-13 Record = 90° 44' 50" Measured = 91° 15' 00"±
Angle line E-13 & F-13 to line E-13 & D-13 Record = 180° 41' 50" Measured = 180° 41' 45"

C. Description of monument for corner and accessories established to perpetuate locating the position of the corner:

E-13) South Corner Common to Sections 32 & 33 T.1 S.,R.10 E.

Found a steel bar in concrete in mon. box at the intersection of Joy Road and South bound Telegraph Road.
The selected location is accepted by the Contractor and is generally accepted by professional surveyors as the best available evidence of the position of the original corner.
Center of signal light post crossing guard N. 72° E. Dist. = 93.56
Found mon. box steel bar in conc. due East Dist. = 180.52
Found nail & tag MDSH tag North face P. pole S.65° E. Dist. = 105.04
Set nail & W.C.R. tag East face P. pole due South Dist. = 66.09
Set nail & W.C.R. tag East face P. pole N.19° W. Dist. = 57.93
Placed Wayne County Remonumentation brass marker stamped with #10705

Signed by William L Roskelly Date 12/27/94
Surveyor's Michigan License No. 10705

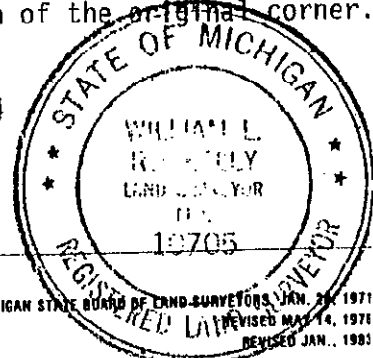

2R
11-D
MISC