

\$ 7.00 DEED
 30 DEC 96 1:47 P.M. RECEIPT# 468
 RECORDED
 FOREST E. YOUNGBLOOD, REGISTER OF DEEDS
 WAYNE COUNTY, MI

LAND CORNER RECORDATION CERTIFICATE
 Filing Requirement of Act 74, Mich. P.A. 1970

\$ 4.00 REMONUMENTATION

L129867PA024

Compliance with
 ACT 345, P.A. 1990

APPROVED ON: 12-18-96 *DBJ*
 WAYNE COUNTY REMONUMENTATION
 PEER GROUP COMMITTEE

Register of Deeds Stamp & File Number

For corners in

Wayne, Redford Twp.
 (County)


Located In: CITY OF DETROIT
 Corner Code #

	T	S.	R	10E	F-3
1. Public Land Survey	T	R.			
	T	R			
	T	R			
	T	R			
2. Property Controlling in Section	S	T	R		
	S	T	R		
3. Miscellaneous Property in Sec.	S	T	R		
	S	T	R		

4. Lot No. _____, Recorded Plat _____
 5. Private Claims _____

I, William L. Roskelly, in a field survey on Dec 10, 1996, do hereby state that under requirements of P.A. 74, Michigan P.A. of 1970, the corner points mentioned in lines 1 and 2 above were in conformance with regulations and rules therefore as required in the current manual of survey instructions of the United States Department of the Interior, Bureau of Land Management or by a decree of a Court of Law and/or that the corner points mentioned in lines 3, 4 and 5 above were in conformance with the rules of the Michigan Board of Land Surveyors or by a Decree of a Court of Law; established, re-established, monumented, recovered, found as expressed below:

NOTE: Not more than 2 corners, all in the same town and range, may be recorded on this certificate.

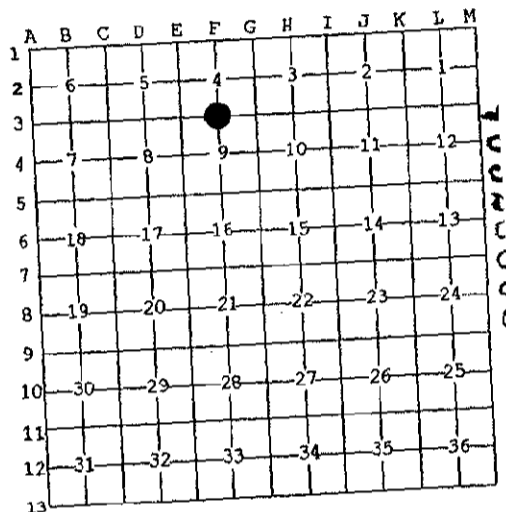

A. Description of original monument and accessories and/or subsequent restoration:

F-3) South corner section 4, T.1 S., R.10 E., Redford Township
 G.L.O. (1830's) Joseph Fletcher set temporary corner post, no witnesses.
 W.P.A. (1930's) no witnesses.
 8/14/72 L. 18184, P. 248 Paul J. Monohon found 1/2" re-rod in mon. box, witnesses: P.K. nail in N.E. face P. pole, S. 32° E. 53.43' (gone), "+" in conc. walk N. 39° E. 50.48 (gone).
 9/5/72 L. 18184, P. 243 Paul J. Monohon found 1/2" re-rod in mon. box, witnesses: P.K. nail in N.E. face P. pole, S. 32° E. 53.43' (gone), "+" in conc. walk N. 39° E. 50.48 (gone).

B. Description of corner evidence found and/or method applied in restoring or reestablishing corner:

F-3) South corner section 4, T.1 S., R.10 E., Redford Township
 Found a steel bar in concrete in a monument box at Seven Mile and Berg roads.
 Verified corner position by comparing City of Detroit Survey with field measurements:
 Distance F-3 to E-3.5 (8th post) Record = 1307.30' Measured = 1306.58'
 Distance F-3 to G-3 Record = 2578.78' Measured = 2578.33'
 Angle line E-3.5 (8th post) & E-3 to E-3.5 (8th post) & F-3 Record = 180° 07' 29", Measured = 180° 08' 19"



C. Description of monument for corner and accessories established to perpetuate locating the position of the corner:

F-3) South corner section 4, T.1 S., R.10 E., Redford Township
 Found a steel bar in concrete in a monument box at Seven Mile and Berg roads.
 The selected location is accepted by the contractor and is generally accepted by professional surveyors as the best available evidence of the position of the corner.
 Witnesses: N. 45° E. 41.81' set nail and WCR tag S.W. face power pole.
 S. 25° E. 59.82' set nail and WCR tag S.E. face power pole.
 S. 46° W. 79.01' set nail and WCR tag N.E. face power pole.
 N. 38° W. 58.04' set nail and WCR tag N.W. face power pole. Placed Wayne County Remonumentation brass marker and cap #10705.

Signed by William L. Roskelly
 Surveyor's Michigan License No. 10705

Date 12-30-96

42
 70
 702