

RC 1242

LI 27015 PA 717

LAND CORNER RECORDATION CERTIFICATE
Filing Requirement of Act 74, Mich. P.A. 1970

For corners in

Wayne

(County)

Located In:

Corner Code -##

- 1. Public Land Survey T 1 S. R 10 E. G-3
2. Property Controlling in Section S T R
3. Miscellaneous Property in Sec. S T R

Compliance with ACT 345, P.A. 1990

APPROVED ON: 12-7-93
WAYNE COUNTY REMONUMENTATION PEER GROUP COMMITTEE

Register of Deeds Stamp & File Number

RC 1242

- 4. Lot No. Recorded Plat
5. Private Claims

Grid table with columns A-M and rows 2-13. A dot is marked at the intersection of column G and row 3.


William L. Roskelly in a field survey on October 28, 1993, do hereby certify that under requirements of P.A. 74, Michigan P.A. of 1970, the corner points mentioned in lines 1 and 2 above were in conformance with regulations and rules therefore as required in the current manual of survey instructions of the United States Department of the Interior, Bureau of Land Management or by a decree of a Court of Law and/or that the corner points mentioned in lines 3, 4 and 5 above were in conformance with the rules of the Michigan Board of Land Surveyors or by a Decree of a Court of Law; established, re-established, monumented, re-monumented, recovered, found as expressed below:

NOTE: Not more than 4 corners, all in the same town and range, may be recorded on this certificate.

A. Description of original monument and accessories and/or subsequent restoration: No G.L.O. witnesses remain. Joseph Fletcher (1814) G.L.O. set corner and witnessed: B. Ash 10 N14 E13 Beech9 S50 E25 L.C.R.C. L. 18184 P. 243 on 9/5/72 Paul J. Monohon found a 1/2" iron rod in a conc. mon. in mon. box and recorded the following witnesses: P.K. nail in N.W. face power pole N. 55° E. 71.23' (gone) P.K. nail in N.E. face power pole S. 39° E. 61.61' (gone)

B. Description of corner evidence found and/or method applied in restoring or reestablishing corner: Found steel bar in concrete mon. in mon box at the intersection of 7 mile and Lahser roads. Also verified section corner thru document L. 18184 P. 243,244 witnesses destroyed. Used Stollman Sub. #3 Plat L.75, P.50 to check distance from G-3 to C/L of Vassar Ave. Measured 1318 +/- Recorded 1317.77. Used Seven Mile Lahser Sub. Plat L.57 P. 78 to check the distance from G-3 to C/L of Cooley Ave. Measured 353.10 +/- Recorded 353.07

C. Description of monument for corner and accessories established to perpetuate locating the position of the corner: G-3: Section corner 3,4,9, & 10 T.1S. R.10E. found steel bar in conc. monument in mon. box. The selected location is accepted by the Contractor and is generally accepted by professional surveyors as the best available evidence of the position of the original corner. Placed Wayne Co. brass disk with license #10705. Found WCRC Tag & PK S.E. face P. Pole N. 40° E. dist. 79.92 Found WCRC Tag & PK N.E. face P. Pole S. 20° E. dist. 79.10 Found WCRC Tag & PK W. face P. Pole S. 54° W. dist. 72.92 Found WCRC Tag & PK W. face P. Pole N. 20° E. dist. 71.80

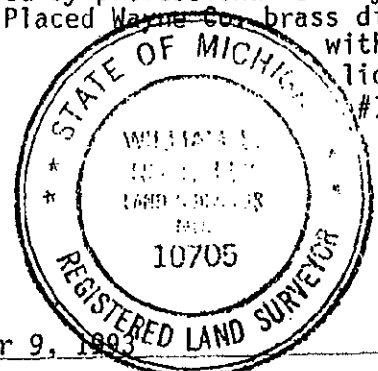

Signed by

William L. Roskelly

Date

November 9, 1993

Surveyor's Michigan License No.

10705

Handwritten initials: 2K 11KD