RC 1243

LI 27015 PA 718

# LAND CORNER RECORDATION CERTIFICATE

**Filing Requirement of Act 74, Mich. P.A. 1970**

For corners in Wayne (County)

| | Located In: | Corner Code # |
|---|---|---|
| 1. Public Land Survey | T 1 S. R 10 E. | G-7 |
| | T ___ R ___ | |
| | T ___ R ___ | |
| | T ___ R ___ | |
| 2. Property Controlling | S ___ T ___ R ___ | |
| in Section | S ___ T ___ R ___ | |
| 3. Miscellaneous | S ___ T ___ R ___ | |
| Property In Sec. | S ___ T ___ R ___ | |

Compliance with ACT 345, P.A. 1990

APPROVED ON: 12-7-93

WAYNE COUNTY REMONUMENTATION PEER GROUP COMMITTEE

Register of Deeds Stamp & File Number

4. Lot No. _____, Recorded Plat _____
5. Private Claims _____

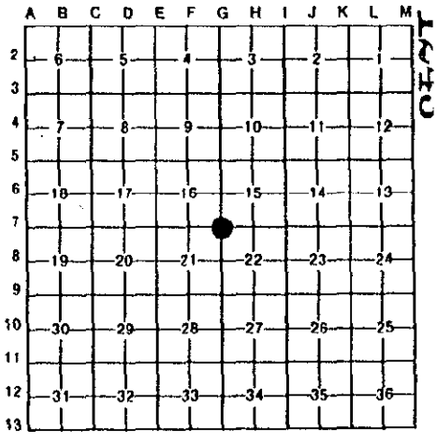


I, William L. Roskelly, in a field survey on October 28, 19 93, do hereby certify that under requirements of P.A. 74, Michigan P.A. of 1970, the corner points mentioned in lines 1 and 2 above were in conformance with regulations and rules therefore as required in the current manual of survey instructions of the United States Department of the Interior, Bureau of Land Management or by a decree of a Court of Law and/or that the corner points mentioned in lines 3, 4 and 5 above were in conformance with the rules of the Michigan Board of Land Surveyors or by a Decree of a Court of Law; established, re-established, monumented, re-monumented, recovered, found as expressed below:

**NOTE: Not more than 4 corners, all in the same town and range, may be recorded on this certificate.**

A. Description of original monument and accessories and/or subsequent restoration:

No G.L.O. witnesses remain.
Joseph Fletcher G.L.O. set temp. corner (1816) Witnesses: Lynn 9N41E26 Beech 9S 9W 33

B. Description of corner evidence found and/or method applied in restoring or reestablishing corner:

Found steel bar in concrete in mon. box at the intersection of Five mile and Lahser roads.

Used Hearne map page 106 "Taylor's Brightmoor Sub." to measure from G-7 to N. occupation line of Lot # 515. recorded=221' measured=221'
Used Hearne map page 107 "Brightmoor-Johns Sub. to measure from G-7 to the E. line of Rockdale Ave. R&M 314.47

C. Description of monument for corner and accessories established to perpetuate locating the position of the corner:

G-7: Section corner 15,16,21, & 22 T.1S. R.10 E. found steel bar in concrete in mon. box. The selected location is accepted by the Contractor and is generally accepted by professional surveyor as the best available evidence of the position of the original corner. Placed Wayne Co. brass disk with license #10705.

Set WCR Tag N.W. face signal pole N. 52° E. dist. 47.13
Set WCR Tag N.E. face signal pole S. 40° E. dist. 41.11
Set WCR Tag in seam of concrete S. 50° W. dist. 43.40
also located 33' south of 5 Mile Road & 29' west of Lasher
Set WCR tag in S.W. face P. pole N. 44° W. dist. 41.17

STATE OF MICHIGAN WILLIAM L. ROSKELLY LAND SURVEYOR No. 10705 REGISTERED LAND SURVEYOR

Signed by William L. Roskelly Date November 9, 1993

Surveyor's Michigan License No. 10705

FORM APPROVED BY MICHIGAN STATE BOARD OF LAND SURVEYORS, JAN. 26, 1971
REVISED MAY 14, 1975
REVISED JAN., 1983

2R 11KD