

RC 1244

LAND CORNER RECORDATION CERTIFICATE
Filing Requirement of Act 74, Mich. P.A. 1970

LI 27015 PA 719

For corners in

Wayne (County)	Located In:	Corner Code #
1. Public Land Survey	T 1 S. R 10 E.	H-1
	T ___ R ___	_____
	T ___ R ___	_____
	T ___ R ___	_____
2. Property Controlling in Section	S ___ T ___ R ___	_____
	S ___ T ___ R ___	_____
3. Miscellaneous Property in Sec.	S ___ T ___ R ___	_____
	S ___ T ___ R ___	_____

Compliance with
ACT 345, P.A. 1990

APPROVED ON: 12-7-93
WAYNE COUNTY REMONUMENTATION
PEER GROUP COMMITTEE

Register of Deeds Stamp & File Number

- 4. Lot No. _____, Recorded Plat _____
- 5. Private Claims _____

William L. Roskelly in a field survey on October 28, 1993, do hereby certify that under requirements of P.A. 74, Michigan P.A. of 1970, the corner points mentioned in lines 1 and 2 above were in conformance with regulations and rules therefore as required in the current manual of survey instructions of the United States Department of the Interior, Bureau of Land Management or by a decree of a Court of Law and/or that the corner points mentioned in lines 3, 4 and 5 above were in conformance with the rules of the Michigan Board of Land Surveyors or by a Decree of a Court of Law; established, re-established, monumented, re-monumented, recovered, found as expressed below:

NOTE: Not more than 4 corners, all in the same town and range, may be recorded on this certificate.

A. Description of original monument and accessories and/or subsequent restoration:
No G.L.O. witnesses remain.


L.C.R.C. 7/15/75 Douglas Hooth reported finding a concrete monument in mon box and recorded the following witnesses: Due South 33.38' P.K. nail in curb. S65 W 61.54 6" Locust Due West 44.98' NE cor. Edison Tower Due East 52.25 P.K. nail and tag in power pole.

B. Description of corner evidence found and/or method applied in restoring or reestablishing corner:

Found monument box with conc. mon. 1" steel bar in center of median
Verified section corner thru document L. 19168, Pg. 902,903
Found PK due south R = 33.38 in curb meas. 33.07
Found 6" Locust S. 65° W. R = 61.54 meas. 61.50± to center of tree, no nail.
Remaining witnesses destroyed.

C. Description of monument for corner and accessories established to perpetuate locating the position of the corner: The selected location is accepted by the Contractor and is generally accepted by professional surveyors as the best available evidence of the position of the original corner. Placed Wayne Co. brass disk with license #10705.

- Set P.K. & WCR tag N.E. face 14" Locust N. 80° E. dist. 67.70
- Center of key hole in watergate S. 46° E. dist. 29.99
- Found P.K. nail top curb due South dist. 33.07
- Set WCR tag S.E. face 8" Pine S. 74° W. dist. 30.15
- Set P.K. nail WCR tag top curb N. 20° W. dist. 38.16

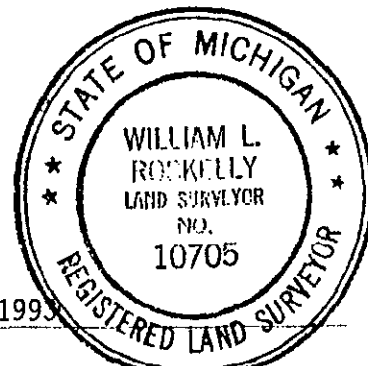

Signed by William L. Roskelly
Surveyor's Michigan License No. 10705

Date November 9, 1993

	A	B	C	D	E	F	G	H	I	J	K	L	M
2	6	5	4	3	2	1							
3													
4	7	8	9	10	11	12							
5													
6	18	17	16	15	14	13							
7													
8	19	20	21	22	23	24							
9													
10	30	29	28	27	26	25							
11													
12	31	32	33	34	35	36							
13													

RC 11KD