

APR 05 1996

COMMISSION

For corners in

Wayne

(County)

Located In: Detroit Corner Code #

1. Public Land Survey	T	1S.	R	10E.	H-7
	T		R		
	T		R		
	T		R		
	T		R		
2. Property Controlling in Section	S	T	R		
	S	T	R		
3. Miscellaneous Property in Sec.	S	T	R		
	S	T	R		

- 4. Lot No. _____, Recorded Plat _____
- 5. Private Claims _____

I, William Roskelly, in a field survey on October 29, 1995, do hereby certify that under requirements of P.A. 74, Michigan P.A. of 1970, the corner points mentioned in lines 1 and 2 above were in conformance with regulations and rules therefore as required in the current manual of survey instructions of the United States Department of the Interior, Bureau of Land Management or by a decree of a Court of Law and/or that the corner points mentioned in lines 3, 4 and 5 above were in conformance with the rules of the Michigan Board of Land Surveyors or by a Decree of a Court of Law; established, re-established, monumented, re-monumented, recovered, found as expressed below:

NOTE: Not more than 4 corners, all in the same town and range, may be recorded on this certificate.

A. Description of original monument and accessories and/or subsequent restoration:

H-7) North corner section 22, T.1 S., R.10 E., Redford Township
 G.L.O. (1830's) Joseph Fletcher set temporary corner post, no witnesses.
 W.P.A. (1930's) No witnesses found.
 No R.C.'s or C.S.'s found on file at Wayne County Register of Deeds.

B. Description of corner evidence found and/or method applied in restoring or reestablishing corner:

H-7) North corner section 22, T.1 S., R.10 E., Redford Township
 Found a concrete monument with steel bar in a monument box in the intersection of Fenkell Ave. and Burt Road (asphalt).
 Verified corner location by comparing City of Detroit data with field measurements:
 H-7 to G-7 Record = 2625.70 Measured = 2625.25 H-7 to I-7 Record = 2619.15 Measured = 2619.42 H-7 to H-8 Record = 2644.25 Measured = 2643.70 +/- using occupation back of walk Lot 260 "BE Taylor's Brightmoor Sub'n." at the NE corner of Burt and Lyndon. H-7 to H-6 Record = 2616.80 +/- from Hearne Brothers map page Measured = 2616.27 H-6 from iron pipe Lot 355 at the NE corner of Burt and Puritan "Grand River Suburban Subdivision" West 33' for occupation tie.
 Angle line H-7 & I-7 to H-7 & G-7 Record = 179° 22' 00" Measured 179° 21' 38"
 Angle line H-7 & I-7 to H-7 & H-8 Record = 89° 42' 00" Measured = 89° 42' 02"

C. Description of monument for corner and accessories established to perpetuate locating the position of the corner:

H-7) North corner section 22, T.1 S., R.10 E., Redford Township
 Found a concrete monument with steel bar in a monument box in the intersection of Fenkell Ave. and Burt Road (asphalt).
 The selected location is accepted by the contractor and is generally accepted by professional surveyors as the best available evidence of the position of the corner.

WITNESSES:

"X" on bronze disc BM = 113.253 N. 34° E. distance = 48.13
 Set nail and WCR tag S.E. face P. pole N.45° E. distance = 37.06 Top bolt of hydrant S. 16° E. distance = 58.19
 Set nail and WCR tag West face P. pole S. 10° E. distance = 67.01 Set nail and WCR tag N.W. face P. pole S. 66° W. distance = 43.07 Top bolt of hydrant N. 24° W. distance = 54.03
 Placed Wayne County Remonumentation brass marker and cap #10705

Signed by William Roskelly Date 12-14-95
 Surveyor's Michigan License No. 10705

\$ 4.00 REMONUMENTATION

\$ 7.00 DEED

19 DEC 95 11:53 A.M. RECEI A

RECORDED

FOREST E. YOUNGBLOOD, REGISTER EDS
WAYNE COUNTY, MI


LIBER 28471 PAGE 670

Compliance with ACT 345, P.A. 1990

APPROVED ON: 12-12-95
WAYNE COUNTY REMONUMENTATION PEER GROUP COMMITTEE

Register of Deeds Stamp & File Number

A	B	C	D	E	F	G	H	I	J	K	L	M
2	6	5	4	3	2	1						
3												
4	7	8	9	10	11	12						
5												
6	13	17	16	15	14	13						
7												
8	19	20	21	22	23	24						
9												
10	30	29	28	27	26	25						
11												
12	31	32	33	34	35	36						
13												

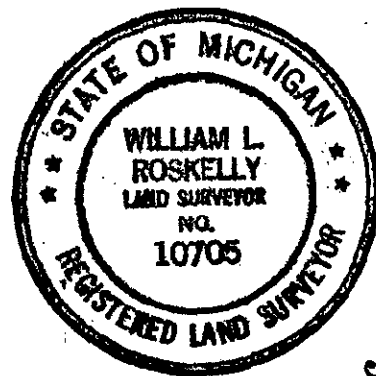

95271386

4R
7D
JZ