

FILE DO NOT MAIL

LAND CORNER RECORDATION CERTIFICATE
Filing Requirement of Act 74, Mich. P.A. 1970

RF [unclear]

FEB 28 2000

For corners in

Wayne, Redford Twp.
(County)

Located In: Detroit

Corner Code #

SECTION

1. Public Land Survey

T	1S.	R	10E	I-3
T		R		
T		R		
T		R		
T		R		
S		T	R	
S		T	R	
S		T	R	
S		T	R	

Liber-30845 Page-20
99592678 12/28/1999
F.E. Youngblood, Wayne Co. Register of Deeds

Compliance with
ACT 345, P.A. 1990

APPROVED ON: DEC. 9, 1999
WAYNE COUNTY REMONUMENTATION
PEER GROUP COMMITTEE

Register of Deeds Stamp & File Number

2. Property Controlling
in Section

3. Miscellaneous
Property in Sec.


4. Lot No. _____, Recorded Plat _____
5. Private Claims _____

I, William L. Roskelly, in a field survey on Dec 2, 1999 do hereby state that under requirements of P.A. 74, Michigan P.A. of 1970, the corner points mentioned in lines 1 and 2 above were in conformance with regulations and rules therefore as required in the current manual of survey instructions of the United States Department of the Interior, Bureau of Land Management or by a decree of a Court of Law and /or that the corner points mentioned in lines 3, 4 and 5 above were in conformance with the rules of the Michigan Board of Land Surveyors or by a Decree of a Court of Law; established, re-established, monumented, recovered, found as expressed below:

NOTE: Not more than 2 corners, all in the same town and range, may be recorded on this certificate.

	A	B	C	D	E	F	G	H	I	J	K	L	M
1													
2	6		5		4		3		2		1		
3													
4	7		8		9		10		11		12		
5													
6	18		17		16		15		14		13		
7													
8	19		20		21		22		23		24		
9													
10	30		29		28		27		26		25		
11													
12	31		32		33		34		35		36		
13													

A. Description of original monument and accessories and/or subsequent restoration:
I-3) Southeast corner section 3, T.1 S., R.10 E., Redford Township, City of Detroit
G.I.O. (1830's) Joseph Fletcher set corner, witnesses: W. 010 S47 E 14, Elm 16 N 86 W37
W.P.A. (1930's) no witnesses.

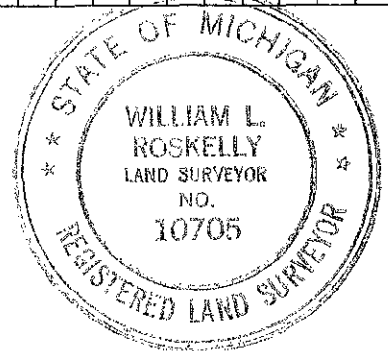

B. Description of corner evidence found and/or method applied in restoring or reestablishing corner:
I-3) Southeast corner section 3, T.1 S., R.10 E., Redford Township, City of Detroit
Found steel bar in concrete monument in monument box at the intersection of Seven Mile and Evergreen Roads (pavement).
Verified corner position by occupation:
Distance to NE occupation 60' N, 60' E.
Distance to SE occupation 60' S, 43' E.
Distance to SW found concrete monument 60.02'S, 52.86'W.

C. Description of monument for corner and accessories established to perpetuate locating the position of the corner:
I-3) Southeast corner section 3, T.1 S., R.10 E., Redford Township, City of Detroit
Found steel bar in concrete monument in monument box at the intersection of Seven Mile and Evergreen Roads (pavement).
The selected location is accepted by the contractor and is generally accepted by professional surveyors as the best available evidence of the position of the corner.
Witnesses: : N 28° 41'04"E 72.73' set nail and WCR tag SW face power pole, N 42° 54'45"E 79.63' found conc mon steel bar in City of Detroit BM mon box, S46° 43'00"E 60.80' top bolt hydrant, S 39° 59'59"E 56.96' set nail and WCR tag NW face power pole, S 24° 56'48"E 68.60' set steel bar and trav cap #10705, S 39° 35'24"W 79.97' found conc mon steel bar, S 43° 24'01"W 76.48' found cut cross in light pole base, N 24° 37'59"W 111.53' set nail and WCR tag E face 8" Maple.
Placed Wayne County Remonumentation brass marker and stamped marker with #10705.

Signed by William L. Roskelly
Surveyor's Michigan License No. 10705

Date 12-28-99

R LCR 9 4R 1/3 H. [unclear]