

FEB 28 2000

FILE DO NOT MAIL

LAND CORNER RECORDATION CERTIFICATE  
Filing Requirement of Act 74, Mich. P.A. 1970

SECTION

For corners in

<u>Wayne, Redford Twp.</u> (County)	Located In <u>Detroit</u>	Corner Code #
1. Public Land Survey	T <u>1S</u> .R <u>10E</u>	<u>I-4</u>
	T <u>   </u> .R <u>   </u>	<u>   </u>
	T <u>   </u> .R <u>   </u>	<u>   </u>
	T <u>   </u> .R <u>   </u>	<u>   </u>
2. Property Controlling in Section	S <u>   </u> .T <u>   </u> .R <u>   </u>	<u>   </u>
	S <u>   </u> .T <u>   </u> .R <u>   </u>	<u>   </u>
3. Miscellaneous Property in Sec.	S <u>   </u> .T <u>   </u> .R <u>   </u>	<u>   </u>
	S <u>   </u> .T <u>   </u> .R <u>   </u>	<u>   </u>

Liber-30845 Page-21  
99592684 12/28/1999  
F.E. Youngblood, Wayne Co. Register of Deeds

Compliance with  
ACT 345, P.A. 1990

APPROVED ON: DEC. 9, 1999

WAYNE COUNTY REMONUMENTATION  
PEER GROUP COMMITTEE

Register of Deeds Stamp & File Number

4. Lot No. \_\_\_\_\_, Recorded Plat \_\_\_\_\_  
5. Private Claims \_\_\_\_\_

I, William L. Roskelly, in a field survey on Dec 1, 1999 do hereby state that under requirements of P.A. 74, Michigan P.A. of 1970, the corner points mentioned in lines 1 and 2 above were in conformance with regulations and rules therefore as required in the current manual of survey instructions of the United States Department of the Interior, Bureau of Land Management or by a decree of a Court of Law and /or that the corner points mentioned in lines 3, 4 and 5 above were in conformance with the rules of the Michigan Board of Land Surveyors or by a Decree of a Court of Law; established, re-established, monumented, recovered, found as expressed below:

A	B	C	D	E	F	G	H	I	J	K	L	M
1												
2	6	5	4	3	2	1						
3												
4	7	8	9	10	11	12						
5												
6	18	17	16	15	14	13						
7												
8	19	20	21	22	23	24						
9												
10	30	29	28	27	26	25						
11												
12	31	32	33	34	35	36						
13												


NOTE: Not more than 2 corners, all in the same town and range, may be recorded on this certificate.

A. Description of original monument and accessories and/or subsequent restoration:  
I-4) East corner section 10, T.1 S., R.10 E., Redford Township, City of Detroit  
G.L.O. (1830's) Joseph Fletcher set corner, no witnesses.  
W.P.A. (1930's) no witnesses.

B. Description of corner evidence found and/or method applied in restoring or reestablishing corner:  
I-4) East corner section 10, T.1 S., R.10 E., Redford Township, City of Detroit  
Set monument and monument box centerline of Evergreen and Curtis Roads (pavement).  
Corner location re-established using the SW corner of lot 2145 sighting the SW corner of lot 2113 and measuring south the record 188' along the subdivision line "Brookline No. 6" L.45, P.18. Turned record angle left 89°45'00" 33.00' to I-4.  
Confirmed corner position field measurements:  
Occupation measured NE corner ROW 33'N and 33'E +/- and SE corner ROW 33'S and 33'E +/-, Due West ROW 33'W.

C. Description of monument for corner and accessories established to perpetuate locating the position of the corner:  
I-4) East corner section 10, T.1 S., R.10 E., Redford Township, City of Detroit  
Set monument and monument box centerline of Evergreen and Curtis Roads (pavement).  
The selected location is a careful and faithful re-establishment of the position of the original corner.  
Witnesses: N 32° 17' 11" E 40.07' set nail and WCR tag SE face guy pole, N 43° 41' 13" E 41.16' found "+" in City of Detroit BM disc, S 45° 55' 24" E 48.97' set nail and WCR tag W face 24" Elm, S 32° 44' 02" E 49.03' top bolt hydrant, S 25° 25' 46" W 47.68' set nail and WCR tag E face light pole, S 69° 41' 24" W 33.38' set steel bar and cap # 10705, N 37° 00' 24" W 38.13' set nail and WCR tag SW face light pole.  
Placed Wayne County Remonumentation brass marker and cap number 10705.

Signed by William L. Roskelly  
Surveyor's Michigan License No. 10705

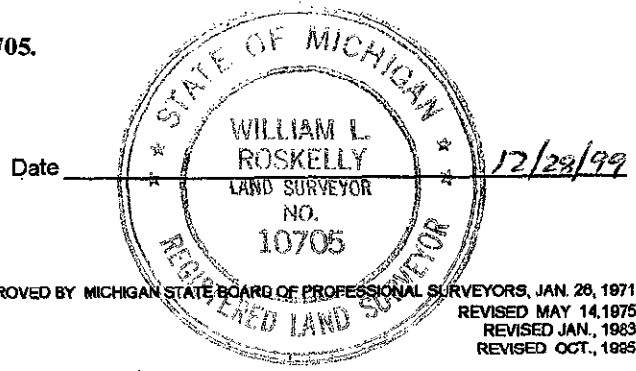

