

FEB 28 2000

SECTION

FILE DO NOT MAIL

LAND CORNER RECORDATION CERTIFICATE  
Filing Requirement of Act 74, Mich. P.A. 1970

For corners in

<u>Wayne, Redford Twp.</u> (County)	Located In: <u>Detroit</u>	Corner Code #
1. Public Land Survey	T 1S. R 10E	I-5
	T _____ R _____	_____
	T _____ R _____	_____
	T _____ R _____	_____
2. Property Controlling in Section	S _____ T _____ R _____	_____
	S _____ T _____ R _____	_____
3. Miscellaneous Property in Sec.	S _____ T _____ R _____	_____
	S _____ T _____ R _____	_____

Liber-30845 Page-22  
99592690 12/28/1999  
F.E. Youngblood, Wayne Co. Register of Deeds

Compliance with  
ACT 345, P.A. 1990

APPROVED ON: DEC. 9, 1999  
WAYNE COUNTY REMONUMENTATION  
PEER GROUP COMMITTEE

Register of Deeds Stamp & File Number

4. Lot No. \_\_\_\_\_, Recorded Plat \_\_\_\_\_  
5. Private Claims \_\_\_\_\_

I, William L. Roskelly, in a field survey on Dec 1, 19 99 do hereby state that under requirements of P.A. 74, Michigan P.A. of 1970, the corner points mentioned in lines 1 and 2 above were in conformance with regulations and rules therefore as required in the current manual of survey instructions of the United States Department of the Interior, Bureau of Land Management or by a decree of a Court of Law and /or that the corner points mentioned in lines 3, 4 and 5 above were in conformance with the rules of the Michigan Board of Land Surveyors or by a Decree of a Court of Law; established, re-established, monumented, recovered, found as expressed below.

NOTE: Not more than 2 corners, all in the same town and range, may be recorded on this certificate.

A	B	C	D	E	F	G	H	I	J	K	L	M
1												
2	6	5	4	3	2	1						
3												
4	7	8	9	10	11	12						
5												
6	18	17	16	15	14	13						
7												
8	19	20	21	22	23	24						
9												
10	30	29	28	27	26	25						
11												
12	31	32	33	34	35	36						
13												


A. Description of original monument and accessories and/or subsequent restoration:  
I-5)Southeast corner section 10, T.1 S., R.10 E., Redford Township, City of Detroit  
G.L.O. (1830's) Joseph Fletcher set corner, Witnesses: Beech 12S 38 W 14, Do 12N 75E 30  
W.P.A. (1930's) no witnesses.

B. Description of corner evidence found and/or method applied in restoring or reestablishing corner:  
I-5)Southeast corner section 10, T.1 S., R.10 E., Redford Township, City of Detroit  
Found iron pipe in concrete in monument box at the intersection of Six Mile and Evergreen Roads (pavement).  
Verified corner position by comparing City of Detroit Survey with field measurements:  
I-5 to J-5 Record =N 88° 40'00"E 2606.41' Measured =N 88° 39'47"E 2606.39'  
I-5 to I-6 Record =S 2° 26'27"E 2661.39' Measured =S 02° 31'11"E 2661.95'  
Corner location supported by occupation. Measured row Six Mile Road 60' +/-N and 60' +/- E. Measured row Evergreen Road 33' +/-N. and 33' +/-W.

C. Description of monument for corner and accessories established to perpetuate locating the position of the corner:  
I-5)Southeast corner section 10, T.1 S., R.10 E., Redford Township, City of Detroit  
Found iron pipe in concrete in monument box at the intersection of Six Mile and Evergreen Roads (pavement).  
The selected location is accepted by the contractor and is generally accepted by professional surveyors as the best available evidence of the position of the corner.  
Witnesses: N 43° 27'34"E 78.45' "+" found City of Detroit BM disc, N 48° 02'17"E 44.41' set steel bar trav cap #10705, N 61° 12'25"E 55.96' set nail and WCR tag N face power pole, S 31° 19'44"E 85.67' set nail and WCR tag NE face power pole, S 49° 39'24"W 119.44' set nail and WCR tag NW face power pole, N 55° 48'00"W 41.64' set nail and WCR tag NE face power pole, N 29° 44'18"W 53.05' top bolt hydrant.  
Placed Wayne County Remonumentation brass marker and stamped marker with #10705.

Signed by William L. Roskelly  
Surveyor's Michigan License No. 10705

Date 12-28-99

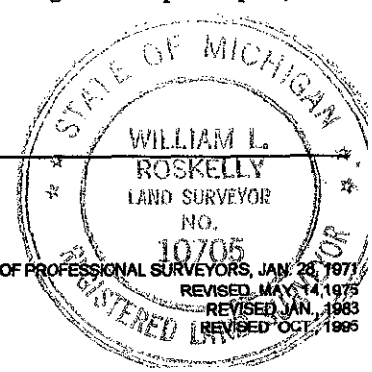

R LCR 9 40 10, A. J. P.