

DEC 29 1998

SURVEY & REMONUMENTATION

Lib 88-30005

FILE DO NOT MAIL

MAR 02 1999

LAND CORNER RECORDATION CERTIFICATE
Filing Requirement of Act 74, Mich. P.A. 1970

For corners in

SECTION

Wayne, Redford Twp.
(County)

Located In: Detroit

Corner Code #

1. Public Land Survey	T <u>1S.</u> R <u>10E</u>	<u>1-8</u>
	T <u> </u> R <u> </u>	<u> </u>
	T <u> </u> R <u> </u>	<u> </u>
	T <u> </u> R <u> </u>	<u> </u>
2. Property Controlling in Section	S <u> </u> T <u> </u> R <u> </u>	<u> </u>
	S <u> </u> T <u> </u> R <u> </u>	<u> </u>
3. Miscellaneous Property in Sec.	S <u> </u> T <u> </u> R <u> </u>	<u> </u>
	S <u> </u> T <u> </u> R <u> </u>	<u> </u>

Compliance with ACT 345, P.A. 1990

APPROVED ON: 12-16-98 *DBJ*
WAYNE COUNTY REMONUMENTATION
PEER GROUP COMMITTEE

Register of Deeds Stamp & File Number

4. Lot No. _____, Recorded Plat _____
5. Private Claims _____

I, William L. Roskelly, in a field survey on Dec 11, 19 98, do hereby state that under requirements of P.A. 74, Michigan P.A. of 1970, the corner points mentioned in lines 1 and 2 above were in conformance with regulations and rules therefore as required in the current manual of survey instructions of the United States Department of the Interior, Bureau of Land Management or by a decree of a Court of Law and/or that the corner points mentioned in lines 3, 4 and 5 above were in conformance with the rules of the Michigan Board of Land Surveyors or by a Decree of a Court of Law; established, re-established, monumented, recovered, found as expressed below:

NOTE: Not more than 2 corners, all in the same town and range, may be recorded on this certificate.

	A	B	C	D	E	F	G	H	I	J	K	L	M
1													
2		6		5		4		3		2		1	
3													
4		7		8		9		10		11		12	
5													
6		18		17		16		15		14		13	
7													
8		19		20		21		22		23		24	
9													
10		30		29		28		27		26		25	
11													
12		31		32		33		34		35		36	
13													

\$7.00 DEED

A. Description of original monument and accessories and/or subsequent restoration:

I-8) East corner section 22, T.1 S., R.10 E., Redford Township, City of Detroit
G.L.O. (1830's) Joseph Fletcher set corner, witnesses: B Ash 10S25E 13 (gone), Do 16N66E 14.01
W.P.A. (1930's) no witnesses.

RECORDED
FOREST E. YOUNGBLOOD, REGISTER OF DEEDS
WAYNE COUNTY, MI
Receipt #101860
\$4.00 REMONUMENTATION

B. Description of corner evidence found and/or method applied in restoring or reestablishing corner:


I-8) East corner section 22, T.1 S., R.10 E., Redford Township, City of Detroit
Set an iron in a monument box at Lyndon and Evergreen roads (pavement).
Established corner position using FSB cap #17806 SE corner lot 260 "Coronado Sub", L.54 P.84 sight SW corner lot 412 in the same sub. R&M N89°-31'-00"E 43' thence S00°-29'-30"E 43' to set corner I-8.
Verified corner position by comparing City of Detroit Survey with field measurements:
Distance I-8 to I-7 Record = 2623.35' Measured = 2622.26'
Distance I-8 to I-9 Record = 2634.80' Measured = 2634.57'
Angle line I-8 & I-7 to I-8 & I-9 Record = 180° 00' 05", Measured = 180° 00' 31"

C. Description of monument for corner and accessories established to perpetuate locating the position of the corner:

I-8) East corner section 22, T.1 S., R.10 E., Redford Township, City of Detroit
Set an iron in a monument box at Lyndon and Evergreen roads (pavement).
The selected location is a careful and faithful re-establishment of the position of the original corner.
Witnesses: N35°-41'-38"E. 40.51' set nail and WCR tag W. face power pole,
S53°-00'-38"E. 56.31' set nail and WCR tag W. face power pole,
S49°-17'-05"W 43.67' set nail and WCR tag N. face power pole,
N40°-02'-29"W 54.40' set nail and WCR tag S. face power pole.
Placed Wayne County Remonumentation brass marker and cap #10705.

Signed by William L. Roskelly
Surveyor's Michigan License No. 10705

Date Dec 28, 1998

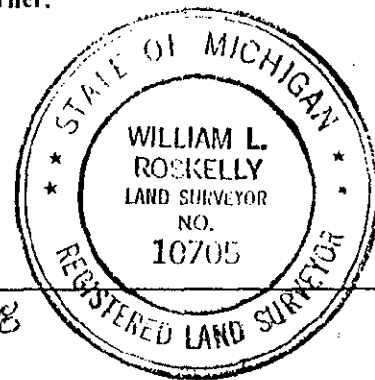

Page-2525.0

9845856015

12/29/1998 11:51AM

R-LCR 7 4R 1PG U DBJ