

DEC 29 1998

FILE DO NOT MAIL

LAND CORNER RECORDATION CERTIFICATE
Filing Requirement of Act 74, Mich. P.A. 1970

SURVEY &
REMONUMENTATION

MAR 02 1999

For corners in

Wayne, Redford Twp.
(County)

Located in: Detroit Corner Code #

- 1. Public Land Survey T 1S. R 10E 1-9
- T R
- T R
- T R
- 2. Property Controlling S T R
- in Section S T R
- 3. Miscellaneous S T R
- Property in Sec. S T R

SECTION

Compliance with
ACT 345, P.A. 1990

APPROVED ON: 12-16-98
WAYNE COUNTY REMONUMENTATION
PEER GROUP COMMITTEE

Register of Deeds Stamp & File Number

- 4. Lot No. _____, Recorded Plat _____
- 5. Private Claims _____

I, William L. Roskelly, in a field survey on Dec 11, 1998, do hereby state that under requirements of P.A. 74, Michigan P.A. of 1970, the corner points mentioned in lines 1 and 2 above were in conformance with regulations and rules therefore as required in the current manual of survey instructions of the United States Department of the Interior, Bureau of Land Management or by a decree of a Court of Law and/or that the corner points mentioned in lines 3, 4 and 5 above were in conformance with the rules of the Michigan Board of Land Surveyors or by a Decree of a Court of Law, established, re-established, monumented, recovered, found as expressed below:

NOTE: Not more than 2 corners, all in the same town and range, may be recorded on this certificate.

1	A	B	C	D	E	F	G	H	I	J	K	L	M
2	6		5		4		3		2		1		
3													
4	7		8		9		10		11		12		
5													
6	18		17		16		15		14		13		
7													
8	19		20		21		22		23		24		
9													
10	30		29		28		27		26		25		
11													
12	31		32		33		34		35		36		
13													

A. Description of original monument and accessories and/or subsequent restoration:

I-9) Southeast corner section 22, T.1 S., R.10 E., Redford Township, City of Detroit.
G.L.O. (1830's) Joseph Fletcher set corner, witnesses: Elm 12N37E 14 (gone), B Ash 12S21E 23 (gone).
W.P.A. (1930's) no witnesses.

\$7.00 DEED
\$4.00 REMONUMENTATION
RECORDED
FOREST E. YOUNGBLOOD, REGISTER OF DEEDS
WAYNE COUNTY, MI
Receipt #101860

B. Description of corner evidence found and/or method applied in restoring or reestablishing corner:


I-9) Southeast corner section 22, T.1 S., R.10 E., Redford Township, City of Detroit.
Set an iron in a monument box at Schoolcraft and Evergreen Roads (pavement).
The corner position re-established using occupation and "Chavey's Schoolcraft Sub.", L.60 P.90.
Verified corner position by comparing City of Detroit Survey with field measurements:
Distance I-9 to I-8 Record = 2634.80' Measured = 2634.57'
Distance I-9 to I-10 Record = 2609.30' Measured = 2609.28'
Angle line I-9 & I-8 to I-9 & I-10 Record = 179° 32' 10", Measured = 179° 31' 48"
I-9 BOC North R=53' M=52.96', East R=53', M=52.74' +/- occupation.

C. Description of monument for corner and accessories established to perpetuate locating the position of the corner:

I-9) Southeast corner section 22, T.1 S., R.10 E., Redford Township, City of Detroit.
Set an iron in a monument box at Schoolcraft and Evergreen Roads (pavement).
The selected location is a careful and faithful re-establishment of the position of the original corner.
Witnesses: N21°-11'-01"E. 113.74 set nail and WCR tag SE. face power pole, N44°-57'-40"E. 64.32' top bolt hydrant,
S44°-12'-28"E. 74.47' set nail WCR tag SW face power pole,
S40°-35'-02"W. 69.74' set nail and WCR tag in concrete walk, N60°-59'-05"W. 75.89'
Placed Wayne County Remonumentation brass marker and cap #10705.

Signed by William L. Roskelly
Surveyor's Michigan License No. 10705

Date Dec. 28
1998

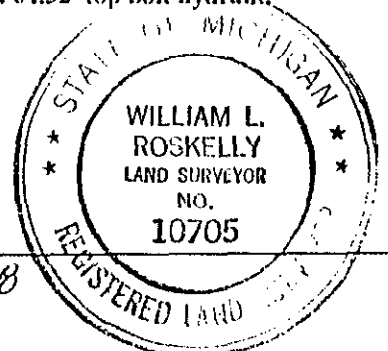

R. L. C. R. 7 4 R. 1 P. G. U. D. P. J.

Libert-38035

Page-2529.0

984585621

12/29/1998 11:52AM