

**SURVEY & REMONUMENTATION**

Liber-29741 Page-2424.0  
97331673LS 12/17/1997 12:07PM

**FILE DO NOT MAIL** MAR 17 1998

**SECOND CORNER RECORDATION CERTIFICATE**  
Filing Requirement of Act 74, Mich. P.A. 1970

For corners in

Wayne, Redford Twp.  
(County)

Located in: DETROIT Corner Code #

- |                                    |  |             |
|------------------------------------|--|-------------|
| 1. Public Land Survey              | T <u>1</u> S. R. <u>10E</u>            | <u>I-11</u> |
|                                    | T <u>   </u> R <u>   </u>              | <u>   </u>  |
|                                    | T <u>   </u> R <u>   </u>              | <u>   </u>  |
|                                    | T <u>   </u> R <u>   </u>              | <u>   </u>  |
| 2. Property Controlling in Section | S <u>   </u> T <u>   </u> R <u>   </u> | <u>   </u>  |
|                                    | S <u>   </u> T <u>   </u> R <u>   </u> | <u>   </u>  |
| 3. Miscellaneous Property in Sec.  | S <u>   </u> T <u>   </u> R <u>   </u> | <u>   </u>  |
|                                    | S <u>   </u> T <u>   </u> R <u>   </u> | <u>   </u>  |

Compliance with  
ACT 345, P.A. 1990  
APPROVED ON: 12-9-97 *DP*  
WAYNE COUNTY REMONUMENTATION  
PEER GROUP COMMITTEE

Register of Deeds Stamp & File Number

4. Lot No. \_\_\_\_\_, Recorded Plat \_\_\_\_\_  
5. Private Claims \_\_\_\_\_

I, William L. Roskelly, in a field survey on Dec 6, 19 97, do hereby state that under requirements of P.A. 74, Michigan P.A. of 1970, the corner points mentioned in lines 1 and 2 above were in conformance with regulations and rules therefore as required in the current manual of survey instructions of the United States Department of the Interior, Bureau of Land Management or by a decree of a Court of Law and for that the corner points mentioned in lines 3, 4 and 5 above were in conformance with the rules of the Michigan Board of Land Surveyors or by a Decree of a Court of Law, established, re-established, monumented, recovered, found as expressed below:


| A | B  | C  | D  | E  | F  | G  | H | I | J | K | L | M |
|---|----|----|----|----|----|----|---|---|---|---|---|---|
|   | 6  | 5  | 4  | 3  | 2  | 1  |   |   |   |   |   |   |
|   |    |    |    |    |    |    |   |   |   |   |   |   |
|   | 7  | 8  | 9  | 10 | 11 | 12 |   |   |   |   |   |   |
|   |    |    |    |    |    |    |   |   |   |   |   |   |
|   | 18 | 17 | 16 | 15 | 14 | 13 |   |   |   |   |   |   |
|   |    |    |    |    |    |    |   |   |   |   |   |   |
|   | 19 | 20 | 21 | 22 | 23 | 24 |   |   |   |   |   |   |
|   |    |    |    |    |    |    |   |   |   |   |   |   |
|   | 30 | 29 | 28 | 27 | 26 | 25 |   |   |   |   |   |   |
|   |    |    |    |    |    |    |   |   |   |   |   |   |
|   | 31 | 32 | 33 | 34 | 35 | 36 |   |   |   |   |   |   |
|   |    |    |    |    |    |    |   |   |   |   |   |   |
|   |    |    |    |    |    |    |   |   |   |   |   |   |

NOTE: Not more than 2 corners, all in the same town and range, may be recorded on this certificate.

A. Description of original monument and accessories and/or subsequent restoration:

I-11) Southeast corner section 27, T.1 S., R.10 E., Redford Township  
G.L.O. (1830's) Joseph Fletcher set corner, witnesses: Elm 12N37E 19 (gone), B Ash 12S21E 23 (gone).  
W.P.A. (1930's) no witnesses.

**\$7.00 DEED**  
**RECORDED**  
**FOREST E. YOUNGBLOOD, REGISTER OF DEEDS**  
**WAYNE COUNTY, MI**  
**\$4.00 REMONUMENTATION**  
**\$8.00 REMONUMENTATION**

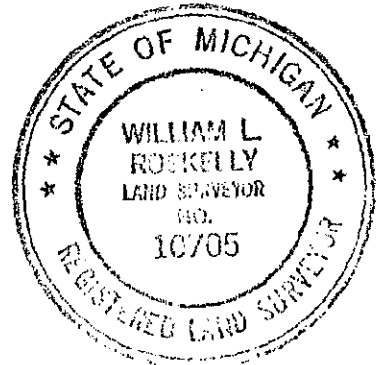

B. Description of corner evidence found and/or method applied in restoring or reestablishing corner:

I-11) Southeast corner section 27, T.1 S., R.10 E., Redford Township  
Set a concrete monument in a monument box at Plymouth and Evergreen roads (pavement).  
Verified corner position by comparing City of Detroit Survey with field measurements:  
Distance I-11 to I-10 Record = 2627.94' Measured = 2627.81'  
Distance I-11 to I-12 Record = 2621.24' Measured = 2620.41'  
Angle line I-11 & I-10 to I-11 & I-12 Record = 179° 55' 46", Measured = 179° 55' 04"  
Established position of corner west from occupation at I-11 to H-11 Record = 2694.09, Measured = 2694.57' +/-.  
Occupation east from Hearn page Record = 690' +/-, Measured = 689.50' +/-  
Checks to occupation Maple's Woods Sub. L. 62, P. 14.

C. Description of monument for corner and accessories established to perpetuate locating the position of the corner:

I-11) Southeast corner section 27, T.1 S., R.10 E., Redford Township  
Set a concrete monument in a monument box at Plymouth and Evergreen roads (pavement).  
The selected location is a careful and faithful re-establishment of the position of the original corner.  
Witnesses: N. 42° 51' 10" E. 74.07' set nail and WCR tag N.W. face power pole, S. 41° 48' 24" E. 79.24' set nail and WCR tag N.E. face power pole, S. 50° 37' 50" W. 91.87' set nail and WCR tag in conc. walk, N. 49° 57' 09" W. 69.61' set nail and WCR tag S.E. face power pole.  
Placed Wayne County Remonumentation brass marker and cap #10705.

Signed by William L. Roskelly  
Surveyor's Michigan License No. 10705

Date 12-16-97

R-100-7-4R-1P DP-1