

RC 1245

LAND CORNER RECORDATION CERTIFICATE

Filing Requirement of Act 74, Mich. P.A. 1970

LI 27015 PA 720

For corners in

Wayne (County)

Located in:

Corner Code -#

- 1. Public Land Survey T 1 S R 10 E. K-3
- T _____ R _____
- T _____ R _____
- T _____ R _____
- 2. Property Controlling S _____ T _____ R _____
- in Section S _____ T _____ R _____
- 3. Miscellaneous S _____ T _____ R _____
- Property in Sec. S _____ T _____ R _____

Compliance with
ACT 345, P.A. 1990

APPROVED ON: 12-7-93 *DPJ*

WAYNE COUNTY REMONUMENTATION
PEER GROUP COMMITTEE

Register of Deeds Stamp & File Number

RC 1245

- 4. Lot No. _____, Recorded Plat _____
- 5. Private Claims _____

	A	B	C	D	E	F	G	H	I	J	K	L	M
2	6	5	4	3	2	1							
3													
4	7	8	9	10	11	12							
5													
6	18	17	16	15	14	13							
7													
8	19	20	21	22	23	24							
9													
10	30	29	28	27	26	25							
11													
12	31	32	33	34	35	36							
13													

I, William L. Roskelly in a field survey on October 28, 1993, do hereby certify that under requirements of P.A. 74, Michigan P.A. of 1970, the corner points mentioned in lines 1 and 2 above were in conformance with regulations and rules therefore as required in the current manual of survey instructions of the United States Department of the Interior, Bureau of Land Management or by a decree of a Court of Law and/or that the corner points mentioned in lines 3, 4 and 5 above were in conformance with the rules of the Michigan Board of Land Surveyors or by a Decree of a Court of Law; established, re-established, monumented, re-monumented, recovered, found as expressed below:

NOTE: Not more than 4 corners, all in the same town and range, may be recorded on this certificate.

A. Description of original monument and accessories and/or subsequent restoration:

No G.L.O. Witnesses remain
Joseph Fletcher G.L.O. (1816) Witnesses: Maple 12N75 WO 20N17 W 53

B. Description of corner evidence found and/or method applied in restoring or reestablishing corner:

Found mon. box with brass disc in concrete with punch hole.
Measured West 313'± to centerline of Ashton Road.
Distance from Hearne Bros. Page #42 = 313.00.

C. Description of monument for corner and accessories established to perpetuate locating the position of the corner:


K-3: Section corner 1,2,11 & 12 T.1 S.R.10 E., found mon. box with brass disc in concrete with punch hole. The selected location is accepted by the Contractor and is generally accepted by professional surveyors as the best available evidence of the position of the original corner. Placed Wayne Co. brass disk with license #10705.

- Set PK & Tag 10705 in conc. overpass N. 32° E. dist. 80.78
- Set PK & Tag 10705 " " " S. 37° E. dist. 73.51
- Set PK & Tag 10705 " " " S. 36° W. dist. 74.05
- Set PK & Tag 10705 " " " N. 34° W. dist. 80.57

Signed by William L. Roskelly

Date November 9, 1993

Surveyor's Michigan License No. 10705

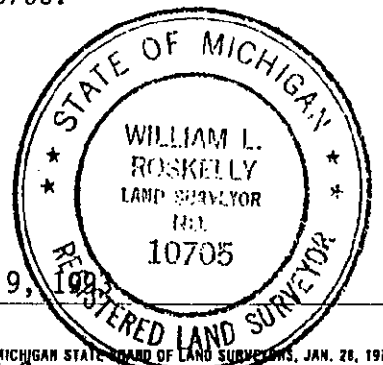

2R 11KD