

LAND CORNER RECORDATION CERTIFICATE
 Filing Requirement of Act 74, Mich. P.A. 1970

\$ 4.00 REMONUMENTATION
 30 DEC 96 1:48 P.M. RECEIPT# 468
 RECORDED
 FOREST E. YOUNGBLOOD, REGISTER OF DEEDS
 WAYNE COUNTY, MI

For corners in

\$ 7.00 DEED
 LI29067PA021

<u>Wayne, Redford Twp.</u> (County)	Located In: City of Detroit	Corner Code # K-6
1. Public Land Survey	T <u>1S.</u> R <u>10E</u>	<u>K-6</u>
	T <u> </u> R <u> </u>	<u> </u>
	T <u> </u> R <u> </u>	<u> </u>
	T <u> </u> R <u> </u>	<u> </u>
2. Property Controlling in Section	S <u> </u> T <u> </u> R <u> </u>	<u> </u>
	S <u> </u> T <u> </u> R <u> </u>	<u> </u>
3. Miscellaneous Property in Sec.	S <u> </u> T <u> </u> R <u> </u>	<u> </u>
	S <u> </u> T <u> </u> R <u> </u>	<u> </u>

Compliance with
 ACT 345, P.A. 1990
 APPROVED ON: 12-18-96
 WAYNE COUNTY REMONUMENTATION
 PEER GROUP COMMITTEE
 Register of Deeds Stamp & File Number

4. Lot No. _____, Recorded Plat _____
 5. Private Claims _____

I, William L. Roskelly, in a field survey on Dec 13, 1996, do hereby state that under requirements of P.A. 74, Michigan P.A. of 1970, the corner points mentioned in lines 1 and 2 above were in conformance with regulations and rules therefore as required in the current manual of survey instructions of the United States Department of the Interior, Bureau of Land Management or by a decree of a Court of Law and /or that the corner points mentioned in lines 3, 4 and 5 above were in conformance with the rules of the Michigan Board of Land Surveyors or by a Decree of a Court of Law; established, re-established, monumented, recovered, found as expressed below:

NOTE: Not more than 2 corners, all in the same town and range, may be recorded on this certificate.


A	B	C	D	E	F	G	H	I	J	K	L	M
1												
2	6	5	4	3	2	1						
3												
4	7	8	9	10	11	12						
5												
6	18	17	16	15	14	13						
7												
8	19	20	21	22	23	24						
9												
10	30	29	28	27	26	25						
11												
12	31	32	33	34	35	36						
13												

A. Description of original monument and accessories and/or subsequent restoration:

K-6 East corner section 14, T.1 S., R.10 E., Redford Township
 G.L.O. (1830's) Joseph Fletcher set corner post, witnesses: W Ash 12S28 E9 (gone), Beech 9N20 E8 (gone).
 W.P.A. (1930's) no witnesses.
 No RC's or CS's found on file at Wayne County.

B. Description of corner evidence found and/or method applied in restoring or reestablishing corner:

K-6 East corner section 14, T.1 S., R.10 E., Redford Township
 Found a bronze disk with punch mark in a monument box at Southfield and Puritan road, concrete.
 Verified corner location by comparing City of Detroit Data with field measurements:
 K-6 to K-5 Record = 2630.58' Measured = 2630.84'
 K-6 to K-7 Record = 2634.18' Measured = 2634.93'
 Angle line K-6 & K-5 to K-6 & K-7 Record = 180°-18'-56" Measured = 180°-16'-19"

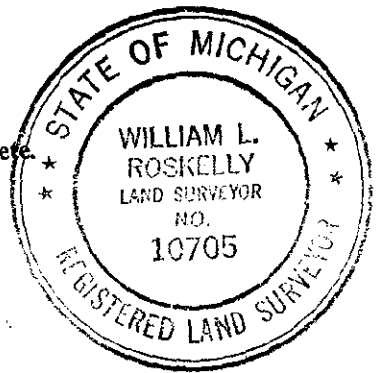

C. Description of monument for corner and accessories established to perpetuate locating the position of the corner:

K-6 East corner section 14, T.1 S., R.10 E., Redford Township
 Found a bronze disk with punch mark in a monument box at Southfield and Puritan road, concrete.
 The selected location is accepted by the contractor and is generally accepted by professional surveyors as the best available evidence of the position of the corner.

WITNESSES:
 Set P.K. nail and WCR tag #10705 in walk N48°-48'-03"E distance=39.61', Set P.K. nail and WCR tag #10705 in walk S49°-55'-33"E distance=42.70', Set P.K. nail and WCR tag #10705 in walk S47°-27'-34"W distance=46.35', Set P.K. nail and WCR tag #10705 in walk N49°-52'-11"W distance=36.36'

Signed by William L. Roskelly
 Surveyor's Michigan License No. 10705

Date 12-30-96

42
70
70