

RC 1245

LI27015 PA 721

LAND CORNER RECORDATION CERTIFICATE
Filing Requirement of Act 74, Mich. P.A. 1970

For corners in

Wayne

(County)

Located In:

Corner Code ##

- 1. Public Land Survey T 1 S R 10 E. K-7
2. Property Controlling in Section S T R
3. Miscellaneous Property in Sec. S T R

Compliance with ACT 345, P.A. 1990

APPROVED ON: 12-7-93
WAYNE COUNTY REMONUMENTATION PEER GROUP COMMITTEE

Register of Deeds Stamp & File Number

- 4. Lot No. Recorded Plat
5. Private Claims

Grid table with columns A-M and rows 2-13. A dot is marked at the intersection of column K and row 7.

I, William L. Roskelly in a field survey on October 28, 1993, do hereby certify that under requirements of P.A. 74, Michigan P.A. of 1970, the corner points mentioned in lines 1 and 2 above were in conformance with regulations and rules therefore as required in the current manual of survey instructions of the United States Department of the Interior, Bureau of Land Management or by a decree of a Court of Law and/or that the corner points mentioned in lines 3, 4 and 5 above were in conformance with the rules of the Michigan Board of Land Surveyors or by a Decree of a Court of Law; established, re-established, monumented, re-monumented, recovered, found as expressed below:

NOTE: Not more than 4 corners, all in the same town and range, may be recorded on this certificate.

A. Description of original monument and accessories and/or subsequent restoration:

No G.L.O. Witnesses remain
Joseph Fletcher G.L.O. (1816) set corner. Witnesses: W0 10S51 W19 B Ash 9 E19


B. Description of corner evidence found and/or method applied in restoring or reestablishing corner:

Found mon. box with bronze disk with punch mark in concrete.
Measured from K-7 to K-8 2633± Recorded distance = 2630.48 "Rosedale Park Subdivision" L. 37, P. 74. Measured K-7 to J-7 2567.56', K-7 to K-8 2633.00±. K-7 to K-6 2634.33±

C. Description of monument for corner and accessories established to perpetuate locating the position of the corner:

K-7: Section corner 13,14,23 & 24 T.1 S.R.10 E. found mon. box with bronze disk, punch mark. The selected location is accepted by the Contractor and is generally accepted by professional surveyors as the best available evidence of the position of the original corner. Placed Wayne Co. brass disk with license #10705.

- Set PK & Tag in conc. overpass bridge N. 40° E. dist. 55.54 Tag #10705
Set " " " " " " " S. 20° E. dist. 33.54 Tag #10705
Set " " " " " " " S. 40° W. dist. 33.77 Tag #10705
Set " " " " " " " N. 30° W. dist. 60.29 Tag #10705

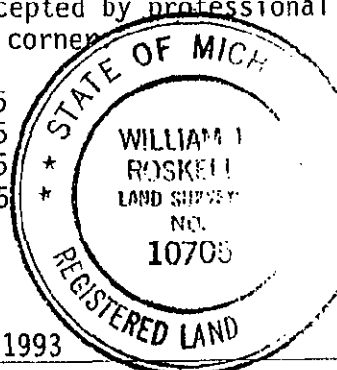

Signed by [Signature]

Date November 9, 1993

Surveyor's Michigan License No. 10705

Handwritten initials: 2R 11KD

RC 1245

RECORDED - 7 PM 2:19