

APR 05 1996

COMMISSION

LAND CORNER RECORDATION CERTIFICATE
Filing Requirement of Act 74, Mich. P.A. 1970

For corners in Wayne (County)

Located in: Detroit Corner Code # K-9

- 1. Public Land Survey T 1S. R 10E
2. Property Controlling in Section S T R
3. Miscellaneous Property in Sec. S T R
4. Lot No. Recorded Plat
5. Private Claims

LIBER 28471 PAGE 673

Compliance with ACT 345, P.A. 1990

APPROVED ON: 12-12-95
WAYNE COUNTY REMONUMENTATION PEER GROUP COMMITTEE

Register of Deeds Stamp & File Number

William Roskelly in a field survey on November 24, 1995

do hereby certify that under requirements of P.A. 74, Michigan P.A. of 1970, the corner points mentioned in lines 1 and 2 above were in conformance with regulations and rules therefore as required in the current manual of survey instructions of the United States Department of the Interior, Bureau of Land Management or by a decree of a Court of Law and/or that the corner points mentioned in lines 3, 4 and 5 above were in conformance with the rules of the Michigan Board of Land Surveyors or by a Decree of a Court of Law; established, re-established, monumented, re-monumented, recovered, found as expressed below:

NOTE: Not more than 4 corners, all in the same town and range, may be recorded on this certificate.

A. Description of original monument and accessories and/or subsequent restoration: K-9) Southwest corner section 24, T.1 S., R.10 E., Redford Township
G.L.O. (1830's) Joseph Fletcher set corner post witnesses: Lynn 12 N21 E16 (gone)
W.P.A. (1930's) No witnesses found.
No R.C.'s or C.S.'s found on file at Wayne County Register of Deeds.

\$ 4.00 REMONUMENTATION
\$ 7.00 DEED
19 DEC 95 11:54 A.M. RECEI A
RECORDED
FOREST E. YOUNGBLOOD, REGISTER ED5
WAYNE COUNTY, MI

Grid table with columns A-M and rows 2-13. A dot is marked at the intersection of column J and row 9.

B. Description of corner evidence found and/or method applied in restoring or reestablishing corner:

K-9) Southwest corner section 24, T.1 S., R.10 E., Redford Township

Found a monument box bronze disc at the intersection of Schoolcraft and Southfield bridge asphalt pavement. Verified corner location by comparing City of Detroit data with field measurements. The locations of J-9, K-8 and L-9 were established by using occupation reference Hearne Brothers maps.

K-9 to J-9 Record = 2627.90 Measured = 2627.56 +/-
K-9 to K-8 Record = 2630.00 Measured = 2629.15 +/-
K-9 to L-9 Record = 2616.60 Measured = 2616.60 +/-
Angle K-9 to J-9 & K-9 to K-8 Record = 89° 37' 19" Measured = 89° 36' 00" +/-
Angle K-9 to K-8 & K-9 to L-9 Record = 90° 44' 30" Measured = 90° 44' 39" +/-

C. Description of monument for corner and accessories established to perpetuate locating the position of the corner:

K-9) Southwest corner section 24, T.1 S., R.10 E., Redford Township

Found a monument box bronze disc at the intersection of Schoolcraft and Southfield bridge asphalt pavement. The selected location is accepted by the contractor and is generally accepted by professional surveyors as the best available evidence of the position of the corner.


WITNESSES:

Set P.K. nail and tag Basney & Smith 10705 concrete walkway seam N. 35° E. distance = 65.35 Top bolt of hydrant N. 44° E. distance = 157.67 Top bolt of hydrant S. 47° E. distance = 117.28 Set P.K. nail and tag Basney & Smith 10705 concrete walkway seam S. 14° E. distance = 32.39 W.C.R.C. B.M. bronze disc period between B.M. S.78° W. distance = 106.33 Top bolt of hydrant S. 84° W. distance = 186.57 Set P.K. nail and tag Basney and Smith 10705 concrete walkway seam N. 20° W. distance = 81.95

Placed Wayne County Remonumentation brass marker and cap #10705

Signed by William Roskelly Date 12-14-95

Surveyor's Michigan License No. 10705

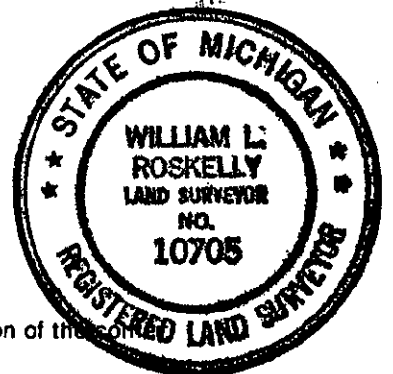

95271389

4R 7D