

**SURVEY &
REMONUMENTATION**

MAR 17 1998

Liber-29741 Page-2425.0
97331674LS 12/17/1997 12:07PM

FILE DO NOT MAIL

SECTION LAND CORNER RECORDATION CERTIFICATE
Filing Requirement of Act 74, Mich. P.A. 1970

For corners in

Wayne, Redford Twp.
(County)

Located In: DETROIT Corner Code # _____

1. Public Land Survey	T	S.	R	10E	K-12
	T		R		
	T		R		
	T		R		
2. Property Controlling in Section	S	T	R		
	S	T	R		
3. Miscellaneous Property in Sec.	S	T	R		
	S	T	R		

Compliance with
ACT 345, P.A. 1990

APPROVED ON: 12-9-97 *DPJ*
**WAYNE COUNTY REMONUMENTATION
PEER GROUP COMMITTEE**

Register of Deeds Stamp & File Number

4. Lot No. _____, Recorded Plat _____
5. Private Claims _____

I, William L. Roskelly, in a field survey on Dec 6, 19 97 do hereby state that under requirements of P.A. 74, Michigan P.A. of 1970, the corner points mentioned in lines 1 and 2 above were in conformance with regulations and rules therefore as required in the current manual of survey instructions of the United States Department of the Interior, Bureau of Land Management or by a decree of a Court of Law and/or that the corner points mentioned in lines 3, 4 and 5 above were in conformance with the rules of the Michigan Board of Land Surveyors or by a Decree of a Court of Law; established, re-established, monumented, recovered, found as expressed below:


NOTE: Not more than 2 corners, all in the same town and range, may be recorded on this certificate.

	A	B	C	D	E	F	G	H	I	J	K	L	M
1													
2	6			5			4			3			2
3													
4	7			8			9			10			11
5													
6	10			17			16			15			14
7													
8	19			20			21			22			23
9													
10	30			29			28			27			26
11													
12													
13													

Receipt #42670
\$4.00 REMONUMENTATION

A. Description of original monument and accessories and/or subsequent restoration:

K-12) East corner section 35, T.1 S., R.10 E., Redford Township
G.L.O. (1830's) Joseph Fletcher set corner, witnesses: Elm 12N37E 19 (gone), B Ash 12S21E 23 (gone).
W.P.A. (1930's) no witnesses.

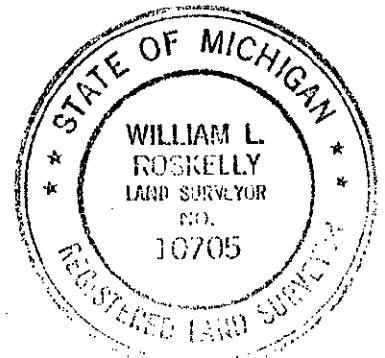

B. Description of corner evidence found and/or method applied in restoring or reestablishing corner:

K-12) East corner section 35, T.1 S., R.10 E., Redford Township
Set a PK nail and WCR tag Southfield Freeway.
Verified corner position by comparing City of Detroit Survey with field measurements:
Distance K-12 to K-11 Record = 2625.85' Measured = 2625.84'
Distance K-12 to K-13 Record = 2629.50' Measured = 2629.98'
Angle line K-12 & K-11 to K-12 & K-13 Record = 179° 59' 28", Measured = 180° 00' 38"
Verified corner position by comparing Hearne Page with field measurements:
Distance K-12 to iron corner ROW W. Chicago and Rosemount Record = 691.34 +/-, Measured = S. 180° 00' 38" W. 691.63'

C. Description of monument for corner and accessories established to perpetuate locating the position of the corner:

K-12) East corner section 35, T.1 S., R.10 E., Redford Township
Set a PK nail and WCR tag Southfield Freeway.
The selected location is a careful and faithful re-establishment of the position of the original corner.
Witnesses: N. 72° 27' 49" E. 109.56' set PK nail and tag #10705 in conc. wall, N. 89° 51' 50" E. 127.09' set steel bar cap #10705, S. 51° 18' 31" E. 161.86' set steel bar cap #10705, S. 35° 05' 05" E. 175.91' set PK nail tag #10705 in conc. wall, S. 06° 03' 10" W. 33.69' found WCRC BM disk in conc. wall period between BM, S. 38° 25' 01" W. 114.09' set steel bar cap #10705, N. 12° 32' 22" W. 32.77' set steel bar cap #10705, N. 01° 17' 53" W. 37.62' set PK and tag #10705.

Signed by William L. Roskelly
Surveyor's Michigan License No. 10705

Date 12-16-97

DPJ