

APR 25 1995

\$ 13.00 MISCELLANEOUS RECORDING  
DEC 94 8:20 A.M. RECEIPT# 120  
RECORDED  
FOREST E. YOUNGBLOOD, REGISTER OF DEEDS  
WAYNE COUNTY, MI

COMMISSION

LAND CORNER RECORDATION CERTIFICATE  
Filing Requirement of Act 74, Mich. P.A. 1970

For corners in

Wayne  
(County)

Located In:

Corner Code #

- 1. Public Land Survey T 1 S R 10 E K-13  
T \_\_\_\_\_ R \_\_\_\_\_  
T \_\_\_\_\_ R \_\_\_\_\_  
T \_\_\_\_\_ R \_\_\_\_\_
- 2. Property Controlling S \_\_\_\_\_ T \_\_\_\_\_ R \_\_\_\_\_  
in Section S \_\_\_\_\_ T \_\_\_\_\_ R \_\_\_\_\_
- 3. Miscellaneous S \_\_\_\_\_ T \_\_\_\_\_ R \_\_\_\_\_  
Property in Sec. S \_\_\_\_\_ T \_\_\_\_\_ R \_\_\_\_\_

Compliance with  
ACT 345, P.A. 1990

APPROVED ON: 12-8-94  
WAYNE COUNTY REMONUMENTATION  
PEER GROUP COMMITTEE

Register of Deeds Stamp & File Number

RC 1558

- 4. Lot No. \_\_\_\_\_, Recorded Plat \_\_\_\_\_
- 5. Private Claims \_\_\_\_\_

	A	B	C	D	E	F	G	H	I	J	K	L	M
2	6	5	4	3	2								
3													
4	7	8	9	10	11	12							
5													
6	18	17	16	15	14	13							
7													
8	19	20	21	22	23	24							
9													
10	30	29	28	27	26	25							
11													
12	31	32	33	34	35	36							
13													

William L. Roskelly in a field survey on November 1, 1994, do hereby certify that under requirements of P.A. 74, Michigan P.A. of 1970, the corner points mentioned in lines 1 and 2 above were in conformance with regulations and rules therefore as required in the current manual of survey instructions of the United States Department of the Interior, Bureau of Land Management or by a decree of a Court of Law and/or that the corner points mentioned in lines 3, 4 and 5 above were in conformance with the rules of the Michigan Board of Land Surveyors or by a Decree of a Court of Law; established, re-established, monumented, re-monumented, recovered, found as expressed below:


NOTE: Not more than 4 corners, all in the same town and range, may be recorded on this certificate.

A. Description of original monument and accessories and/or subsequent restoration:  
K-13 SOUTH CORNER COMMON TO SECTIONS 35 AND 36, T. 1 S., R. 10 E.,  
G.L.O. (1830's) Joseph Fletcher set corner, witnesses Beech 12 S. 65 W. 6 (gone),  
Sug. 12 S. 75 E. 20 (gone).  
W.P.A. (1930's) no information found SOUTHFIELD  
Fall and Basney (September 1956) found a concrete monument in mon. box at the intersection of centerlines of Inkster and Joy Roads, witnesses: N.W. 136.14 N.E. building corner gas station (gone), S.W. 86.23 N.E. building corner store (gone), S.E. 62.92 P.K. nail (gone), N.E. 173.00 building corner gas station (gone).  
No R.C.'s or C.S.'s found on file at Wayne County Reg. of Deeds.

B. Description of corner evidence found and/or method applied in restoring or reestablishing corner:  
K-13 SOUTH CORNER COMMON TO SECTIONS 35 AND 36, T. 1 S., R. 10 E.,  
Found a 2" iron in concrete in a monument box at the intersection of Joy and Southfield Roads. Verified corner location by comparing City of Detroit data with field measurements.  
K-13 to J-13 Record = 2630.85 Measured = 2631.58  
K-13 to center of mon. box to the S. K-2 T.2 S., R.10 E. (no iron in mon. box) Measured = 2632.79±  
K-13 to L-13 Record = 2634.82 Measured = 2634.79  
Angle line K-13 & J-13 to line K-13 & K-2 to center of mon. box T.2 S., R.10 E.,  
Measured = 90° 29' 38"  
Angle line K-13 & K-2 to center of mon. box T.2 S., R.10 E. to line K-13 & L-13  
Measured = 89° 31' 11" ±

2 R  
11 D  
MISC

C. Description of monument for corner and accessories established to perpetuate locating the position of the corner:  
K-13 SOUTH CORNER COMMON TO SECTIONS 35 AND 36, T. 1 S., R. 10 E.,  
Placed Wayne County Remonumentation brass marker stamped with #10705.

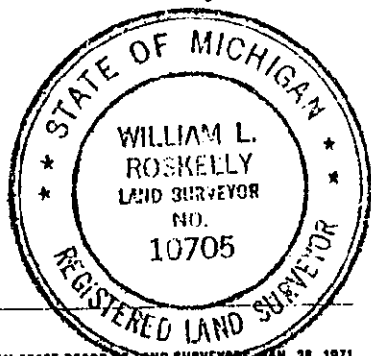

Signed by William L. Roskelly Date 12/27/94  
Surveyor's Michigan License No. 10705