

SURVEY & REMONUMENTATION

RC 1559

LI27800PA050

APR 25 1995

COMMISSION

LAND CORNER RECORDATION CERTIFICATE
Filing Requirement of Act 74, Mich. P.A. 1970

\$ 13.00 MISCELLANEOUS RECORDING
 DEC 94 8:20 A.M. RECEIPT# 120
 RECORDED
 FOREST E. YOUNGBLOOD, REGISTER OF DEEDS
 WAYNE COUNTY, MI

For corners in

Wayne

(County)

Located In:

Corner Code #

- | | | |
|---------------------------------------|----------------------------|------------|
| 1. Public Land Survey | T <u>1</u> S R <u>10</u> E | <u>L-3</u> |
| | T _____ R _____ | _____ |
| | T _____ R _____ | _____ |
| | T _____ R _____ | _____ |
| 2. Property Controlling in Section | S _____ T _____ R _____ | _____ |
| | S _____ T _____ R _____ | _____ |
| 3. Miscellaneous Property in Sec. | S _____ T _____ R _____ | _____ |
| | S _____ T _____ R _____ | _____ |
| 4. Lot No. _____, Recorded Plat _____ | | |
| 5. Private Claims _____ | | |

Compliance with
 ACT 345, P.A. 1990

APPROVED ON: 12-8-94
 WAYNE COUNTY REMONUMENTATION
 PEER GROUP COMMITTEE

Register of Deeds Stamp & File Number

RC 1559

	A	B	C	D	E	F	G	H	I	J	K	L	M
2	6	5	4	3	2	1							
3													
4	7	8	9	10	11	12							
5													
6	16	17	18	15	14	13							
7													
8	19	20	21	22	23	24							
9													
10	30	29	28	27	26	25							
11													
12	31	32	33	34	35	36							
13													

I, William L. Roskelly in a field survey on November 1, 1994, do hereby certify that under requirements of P.A. 74, Michigan P.A. of 1970, the corner points mentioned in lines 1 and 2 above were in conformance with regulations and rules therefore as required in the current manual of survey instructions of the United States Department of the Interior, Bureau of Land Management or by a decree of a Court of Law and/or that the corner points mentioned in lines 3, 4 and 5 above were in conformance with the rules of the Michigan Board of Land Surveyors or by a Decree of a Court of Law; established, re-established, monumented, re-monumented, recovered, found as expressed below:

NOTE: Not more than 4 corners, all in the same town and range, may be recorded on this certificate.

A. Description of original monument and accessories and/or subsequent restoration:
L-3 SOUTH CORNER COMMON TO SECTIONS 1 AND 12, T. 1 S., R. 10 E.

G.L.O. (1830's) Joseph Fletcher set temporary corner no witnesses in field notes.
 W.P.A. (1930's) no witnesses found.

No R.C.'s or C.S.'s found on file at Wayne County Register of Deeds.

B. Description of corner evidence found and/or method applied in restoring or reestablishing corner:

L-3 SOUTH CORNER COMMON TO SECTIONS 1 AND 12, T. 1 S., R. 10 E.

Found an iron pipe concrete monument in mon. box at the intersection of 7 Mile & Asbury Park Roads
 Verified corner location by comparing City of Detroit data with field measurements:
 L-3 to K-3 Record = 2630.73 Measured = 2630.61
 L-3 to M-3 Record = 2623.40 Measured = 2623.18
 Angle line L-3 & K-3 to line L-3 & M-3 Record = 178° 47' 20" Measured = 178° 47' 57"

C. Description of monument for corner and accessories established to perpetuate locating the position of the corner:

L-3 SOUTH CORNER COMMON TO SECTIONS 1 AND 12, T. 1 S., R. 10 E.

Found an iron pipe concrete monument in mon. box at the intersection of 7 Mile & Asbury Park Roads
 The selected location is accepted by the Contractor and is generally accepted by professional surveyors as the best available evidence of the position of the original corner.


WITNESSES:

Top bolt of hydrant N. 32° E. Dist. = 57.26
 Set W.C.R. Tag & nail N.E. face P. pole S. 40° E. Dist. = 49.83
 Found W.C.R.C. tag & P.K. S.E. face P. Pole S. 32° W. Dist. = 59.49
 Found W.C.R.C. Tag & P.K. N.E. face P. pole N. 11° W. Dist. = 58.09

Placed Wayne County Remonumentation brass marker with cap #10705.

Signed by William L. Roskelly Date 12/27/94

Surveyor's Michigan License No. 10705

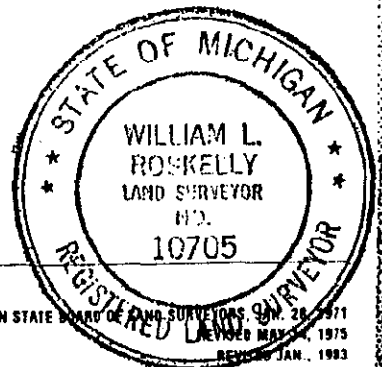

2R
 11D
 MISC