

\$ 7.00 DEED
 30 DEC 96 1:48 P.M. RECEIPT# 489
 RECORDED
 FOREST E. YOUNGBLOOD, REGISTER OF DEEDS
 WAYNE COUNTY, MI

LAND CORNER RECORDATION CERTIFICATE
 Filing Requirement of Act 74, Mich. P.A. 1970

For corners in

<u>Wayne, Redford Twp.</u> (County)	Located In:	Corner Code #
	City of Detroit	
1. Public Land Survey	T <u>1S.</u> R <u>10E</u>	<u>L-5</u>
	T _____ R _____	_____
	T _____ R _____	_____
	T _____ R _____	_____
2. Property Controlling in Section	S _____ T _____ R _____	_____
	S _____ T _____ R _____	_____
3. Miscellaneous Property in Sec.	S _____ T _____ R _____	_____
	S _____ T _____ R _____	_____

\$ 4.00 REMONUMENTATION
 LI29367PA022
 Compliance with
 ACT 345, P.A. 1990
 APPROVED ON: 12-18-96
 WAYNE COUNTY REMONUMENTATION
 PEER GROUP COMMITTEE
 Register of Deeds Stamp & File Number

4. Lot No. _____, Recorded Plat _____
 5. Private Claims _____


I, William L. Roskelly, in a field survey on Dec 5, 19 96 do hereby state that under requirements of P.A. 74, Michigan P.A. of 1970, the corner points mentioned in lines 1 and 2 above were in conformance with regulations and rules therefore as required in the current manual of survey instructions of the United States Department of the Interior, Bureau of Land Management or by a decree of a Court of Law and/or that the corner points mentioned in lines 3, 4 and 5 above were in conformance with the rules of the Michigan Board of Land Surveyors or by a Decree of a Court of Law; established, re-established, monumented, recovered, found as expressed below:

NOTE: Not more than 2 corners, all in the same town and range, may be recorded on this certificate.

	A	B	C	D	E	F	G	H	I	J	K	L	M
1													
2	6		5		4		3		2		1		
3													
4	7		8		9		10		11		12		
5													
6	18		17		16		15		14		13		
7													
8	19		20		21		22		23		24		
9													
10	30		29		28		27		26		25		
11													
12	31		32		33		34		35		36		
13													

A. Description of original monument and accessories and/or subsequent restoration:

L-5) South corner section 12, T.1 S., R.10 E., Redford Township
 G.L.O. (1830's) Joseph Fletcher set corner post, witnesses: Beech 9N48 W3 (gone), Elm 16S16 W20 (gone).
 W.P.A. (1930's) no witnesses.
 No RC's or CS's found on file at Wayne County.

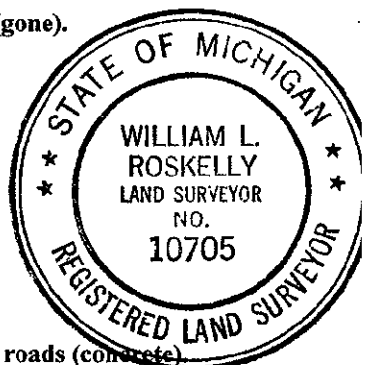

B. Description of corner evidence found and/or method applied in restoring or reestablishing corner:

L-5) South corner section 12, T.1 S., R.10 E., Redford Township
 Found a steel bar in a concrete monument in a monument box centerline of 6 Mile and Asbury Park roads (concrete).
 Verified corner location by comparing City of Detroit coordinate data with field measurements.
 L-5 to K-5 Record = 2636.42' Measured = 2637.33'
 Angle line K-5 & K-4 to K-5 & L-5 Record = 89°-46'-36" Measured = 89°-46'-18"
 Angle line K-5 & L-5 to K-5 & K-6 Record = 89°-50'-46" Measured = 89°-52'-02"

C. Description of monument for corner and accessories established to perpetuate locating the position of the corner:

L-5) South corner section 12, T.1 S., R.10 E., Redford Township
 Found a steel bar in a concrete monument in a monument box centerline of 6 Mile and Asbury Park roads (concrete).
 The selected location is accepted by the contractor and is generally accepted by professional surveyors as the best available evidence of the position of the corner. WITNESSES: Set P.K. nail and WCR tag NW face power pole N. 52° 53' 20" E. 58.52', Set P.K. nail and WCR tag SW face power pole S. 44° 32' 33" E. 44.20', Set P.K. nail and WCR tag NW face power pole S. 22° 20' 37" W. 57.64', Set P.K. nail and WCR tag SW face power pole N. 41° 09' 04" W. 40.35'.
 Placed Wayne County Remonumentation brass marker and cap #10705.

Signed by William L. Roskelly
 Surveyor's Michigan License No. 10705

Date 12-30-96
 4R
 7D
 Jg