

FILE DO NOT MAIL

RF

FEB 28 2000

LAND CORNER RECORDATION CERTIFICATE
Filing Requirement of Act 74, Mich. P.A. 1970

SECTION

For corners in

Wayne, Redford Twp.
(County)

Located in: Detroit

Corner Code #

Liber-30845 Page-24
99592697 12/28/1999

F.E. Youngblood, Wayne Co. Register of Deeds
RDANDSYL

- 1. Public Land Survey T1S. R10E M-1
2. Property Controlling in Section S T R
3. Miscellaneous Property in Sec. S T R

Compliance with ACT 345, P.A. 1990
APPROVED ON: DEC. 9, 1999
WAYNE COUNTY REMONUMENTATION PEER GROUP COMMITTEE
Register of Deeds Stamp & File Number

4. Lot No. Recorded Plat
5. Private Claims

I, William L. Roskelly, in a field survey on Dec 2, 1999 do hereby state that under requirements of P.A. 74, Michigan P.A. of 1970, the corner points mentioned in lines 1 and 2 above were in conformance with regulations and rules therefore as required in the current manual of survey instructions of the United States Department of the Interior, Bureau of Land Management or by a decree of a Court of Law and/or that the corner points mentioned in lines 3, 4 and 5 above were in conformance with the rules of the Michigan Board of Land Surveyors or by a Decree of a Court of Law; established, re-established, monumented, recovered, found as expressed below:

NOTE: Not more than 2 corners, all in the same town and range, may be recorded on this certificate.

Grid table with columns A-M and rows 1-13. Contains numbers 1-36 in a grid pattern.


A. Description of original monument and accessories and/or subsequent restoration:
M-1)Northeast corner section 1, T.1 S., R.10 E., Redford Township, City of Detroit
G.L.O. (1830's) Joseph Fletcher set corner, Witnesses: B. Ash 69 cor tree.
W.P.A. (1930's) no witnesses.

B. Description of corner evidence found and/or method applied in restoring or reestablishing corner:
M-1)Northeast corner section 1, T.1 S., R.10 E., Redford Township, City of Detroit
Found iron pipe in concrete in monument box (intersection of Eight Mile Road and Greenfield Road pavement).
Corner location re-established by comparing field measurements with Joseph Kapelozks 1997 survey L.17932, P.900: Found cut cross SW bolt signal base Record = N24°E 124.75', Measured = N11°26'29"E 124.73', found cut cross NW signal base R. =S22°E 102.32', M. = S35°02'10"E 102.45', found cut cross NE bolt strain pole R. =S57°W 116.87', M.= S24°07'55"W 116.93', found cut cross NE headwall R. =N24° W 157.19', M.= N36°56'58"W 157.10' .Samuel Walker 1982 L.8258. P.207 Found CL 8" traffic crossing light pole R.= N30°E 58.50'M. = N27°01'55"E 58.43', found SE corner bridge pillar R. =S45° W 72.05', M.= S57°25'32"W 72.18', found NE corner bridge pillar R. =N45° W 75.50', M.= N56°48'55"W 75.40',

C. Description of monument for corner and accessories established to perpetuate locating the position of the corner:
M-1)Northeast corner section 1, T.1 S., R.10 E., Redford Township, City of Detroit
Found iron pipe in concrete in monument box (intersection of Eight Mile Road and Greenfield Road pavement).
The selected location is accepted by the contractor and is generally accepted by professional surveyors as the best available evidence of the position of the corner. Note: M-1 is common to M-13 & A-13 Oakland County, A-1 Greenfield Twp in Wayne Co.
Witnesses: N12° 56'32"E 128.95' found steel bar cap #22705 & #17089 in walk, N22° 08'24"E 119.94' found PK nail in walk, N29°19'03"E 59.00' set steel bar cap #10705 in walk seam, S52°28'33"E 42.96' set steel bar cap #10705 in walk seam, S32°24'05"W 114.50' set steel bar cap #10705 in walk seam, N47°17'59"W 76.78' set steel bar cap #10705.
Placed Wayne County Remonumentation brass marker and stamped marker with #10705.

Signed by [Signature]
Surveyor's Michigan License No. 10705

Date 12-28-99

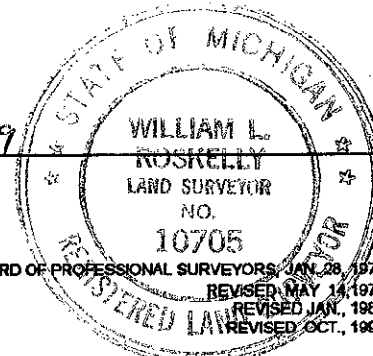

R LOR 9 40 1/2 A [Signature]