

**SURVEY &
REMONUMENTATION**

RC 1159

LI 26992 PA 846

FEB 28 1994

**LAND CORNER RECORDATION CERTIFICATE
Filing Requirement of Act 74, Mich. P.A. 1970**

For corners in


COMMISSION

<u>Wayne</u> (County)	Located In: <u>City of Detroit</u>	Corner Code # <u>A-7</u>
1. Public Land Survey	T <u>1</u> S R <u>11</u> E	<u>A-7</u>
	T _____ R _____	_____
	T _____ R _____	_____
	T _____ R _____	_____
2. Property Controlling in Section	S _____ T _____ R _____	_____
	S _____ T _____ R _____	_____
3. Miscellaneous Property in Sec.	S _____ T _____ R _____	_____
	S _____ T _____ R _____	_____

Compliance with
ACT 345, P.A. 1990
APPROVED ON: 11-30-93 *DBJ*
WAYNE COUNTY REMONUMENTATION
PEER GROUP COMMITTEE

Register of Deeds Stamp & File Number

4. Lot No. _____, Recorded Plat _____
5. Private Claims _____

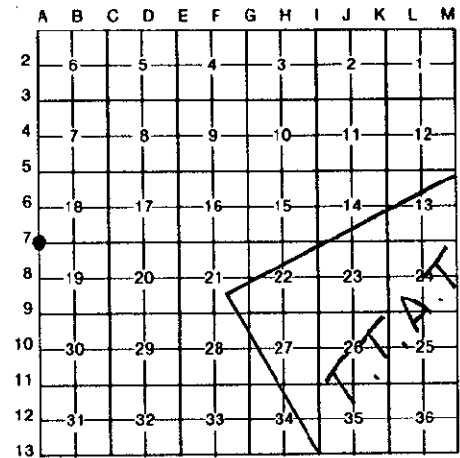

I, Steven E. Dunn, in a field survey on November 6, 19 93, do hereby certify that under requirements of P.A. 74, Michigan P.A. of 1970, the corner points mentioned in lines 1 and 2 above were in conformance with regulations and rules therefore as required in the current manual of survey instructions of the United States Department of the Interior, Bureau of Land Management or by a decree of a Court of Law and/or that the corner points mentioned in lines 3, 4 and 5 above were in conformance with the rules of the Michigan Board of Land Surveyors or by a Decree of a Court of Law; established, re-established, monumented, re-monumented, recovered, found as expressed below:

NOTE: Not more than 4 corners, all in the same town and range, may be recorded on this certificate.

- A. Description of original monument and accessories and/or subsequent restoration:
GLO - Post No GLO Witnesses remain

GLO original survey performed by Joseph Fletcher from contract dated 3 Sep 1816



- B. Description of corner evidence found and/or method applied in restoring or reestablishing corner:
Found 1" Iron rod in monument box.

Verified using found monuments & irons along Greenfield & Fenkell with reference to B.E. Taylor's Belmont Sub'n L.41, P.44, W.C.R.

Placed Wayne County Remonumentation marker on 1" Iron Rod in Monument Box.

- C. Description of monument for corner and accessories established to perpetuate locating the position of the corner:
Wayne County Remonumentation marker on 1" iron rod in monument box

Witnesses

- | | |
|--|-----------------|
| - Set P.K. Nail and W.C.R. witness tag @ SW face utility pole | N.36°W - 50.83' |
| - Set P.K. Nail and W.C.R. witness tag @ SW face utility pole | S.60°E - 69.23' |
| - Set P.K. Nail and W.C.R. witness tag @ asphalt near back of walk | S.48°W - 42.52' |
| - Set P.K. Nail and W.C.R. witness tag @ top of concrete curb | N.66°E - 63.06' |

The selected location is a careful and faithful perpetuation of the position of the original corner.

Signed by Steven E. Dunn Date Nov. 30, 1993

Surveyor's Michigan License No. 28408

93 NOV 30 PM 4: 23
 FOREST E. YOUNGBLOOD
 REGISTER OF DEEDS
 WAYNE COUNTY, MI

20
11