

FEB 28 1994

LAND CORNER RECORDATION CERTIFICATE  
Filing Requirement of Act 74, Mich. P.A. 1970

LI 26992 PA 847

For corners in COMMISSION  
Wayne  
(County)

Located In: \_\_\_\_\_  
City of Detroit Corner Code #

- 1. Public Land Survey T IS R IIE B-3  
T \_\_\_\_\_ R \_\_\_\_\_  
T \_\_\_\_\_ R \_\_\_\_\_  
T \_\_\_\_\_ R \_\_\_\_\_
- 2. Property Controlling S \_\_\_\_\_ T \_\_\_\_\_ R \_\_\_\_\_  
in Section S \_\_\_\_\_ T \_\_\_\_\_ R \_\_\_\_\_
- 3. Miscellaneous S \_\_\_\_\_ T \_\_\_\_\_ R \_\_\_\_\_  
Property in Sec. S \_\_\_\_\_ T \_\_\_\_\_ R \_\_\_\_\_
- 4. Lot No. \_\_\_\_\_, Recorded Plat \_\_\_\_\_
- 5. Private Claims \_\_\_\_\_

Compliance with  
ACT 345, P.A. 1990

APPROVED ON: 11-30-93  
WAYNE COUNTY REMONUMENTATION  
PEER GROUP COMMITTEE

Register of Deeds Stamp & File Number

I, Martin C. Dunn, in a field survey on November 23, 19 93, do hereby certify that under requirements of P.A. 74, Michigan P.A. of 1970, the corner points mentioned in lines 1 and 2 above were in conformance with regulations and rules therefore as required in the current manual of survey instructions of the United States Department of the Interior, Bureau of Land Management or by a decree of a Court of Law and/or that the corner points mentioned in lines 3, 4 and 5 above were in conformance with the rules of the Michigan Board of Land Surveyors or by a Decree of a Court of Law; established, re-established, monumented, re-monumented, recovered, found as expressed below:

**NOTE: Not more than 4 corners, all in the same town and range, may be recorded on this certificate.**

A. Description of original monument and accessories and/or subsequent restoration:

G.L.O. - Post set in original government survey by Joseph Fletcher, contract dated Sept. 3, 1816.

No original evidence found.

B. Description of corner evidence found and/or method applied in restoring or reestablishing corner:

Found Mon. with 1/2" pipe in mon. box.

Verified using found property corners along with sidewalk & curb splits with reference to San Bernardo Park Sub'n L.48, P.61 W.C.R.; San Bernardo Park Sub'n No. 2 L.52, P.28, W.C.R.; Blackstone Park Sub'n No. 2 L.49, P.47, W.C.R.; Blackstone Park No. 3 L.49, P.84, W.C.R.

Placed Wayne County Remonumentation marker & plastic cap #30081 on mon with 1/2" iron pipe in mon. box.

C. Description of monument for corner and accessories established to perpetuate locating the position of the corner:

Wayne County Remonumentation marker & plastic cap #30081 on mon. with 1/2" iron pipe in mon. box.



Witnesses

- Set P.K. nail with W.C.R. tag in W. face utility pole 22°AZ. - 63.41'
- Set P.K. nail with W.C.R. tag in W. face utility pole 137°AZ. - 47.36'
- Set P.K. nail with W.C.R. tag in S. face utility pole 245°AZ. - 75.71'
- Set P.K. nail with W.C.R. tag in S.W. face utility pole 306°AZ. - 57.21'

The selected location is a careful and faithful perpetuation of the position of the original corner.

Signed by Martin C. Dunn Date 11/24/93

Surveyor's Michigan License No. 30081

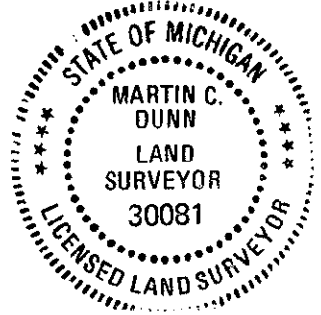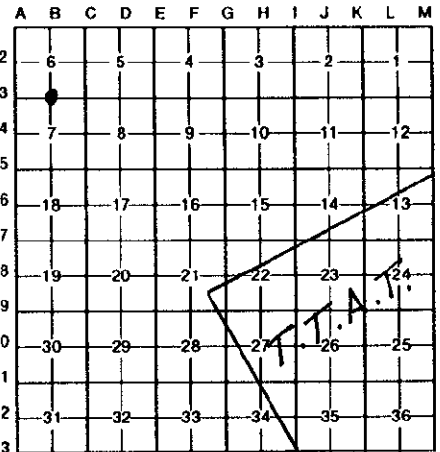

93 NOV 30 PM 4: 23  
FORESTER, YOUNGBLOOD  
REGISTER OF DEEDS  
WAYNE COUNTY, MI