

**SURVEY & REMONUMENTATION LAND CORNER RECORDATION CERTIFICATE**  
**Filing Requirement of Act 74, Mich. P.A. 1970**

LIBER 28452 PAGE 754

For corners in APR 05 1996

**WAYNE**

(County)

**COMMISSION**

Located In: **GREENFIELD TWP  
(NOW CITY OF DETROIT)**

Corner Code #

- |                                    |   |    |   |     |      |
|------------------------------------|---|----|---|-----|------|
| 1. Public Land Survey              | T | 1S | R | 11E | C-12 |
|                                    | T |    | R |     |      |
|                                    | T |    | R |     |      |
|                                    | T |    | R |     |      |
| 2. Property Controlling in Section | S |    | T | R   |      |
|                                    | S |    | T | R   |      |
| 3. Miscellaneous Property in Sec.  | S |    | T | R   |      |
|                                    | S |    | T | R   |      |

Compliance with ACT 345, P.A. 1990

APPROVED ON: DEC 5 1995 *ncd.*  
 WAYNE COUNTY REMONUMENTATION  
 PEER GROUP COMMITTEE

Register of Deeds Stamp & File Number

4. Lot No. \_\_\_\_\_, Recorded Plat \_\_\_\_\_  
 5. Private Claims \_\_\_\_\_

A	B	C	D	E	F	G	H	I	J	K	L	M
2	6	5	4	3	2	1						
3												
4	7	8	9	10	11	12						
5												
6	18	17	16	15	14	13						
7												
8	19	20	21	22	23	24						
9												
10	30	29	28	27	26	25						
11												
12	31	32	33	34	35	36						
13												

I, STEVEN E. DUNN, in a field survey on OCTOBER 8, 19 95, do hereby certify that under requirements of P.A. 74, Michigan P.A. of 1970, the corner points mentioned in lines 1 and 2 above were in conformance with regulations and rules therefore as required in the current manual of survey instructions of the United States Department of the Interior, Bureau of Land Management or by a decree of a Court of Law and /or that the corner points mentioned in lines 3, 4 and 5 above were in conformance with the rules of the Michigan Board of Land Surveyors or by a Decree of a Court of Law; established, re-established, monumented, re-monumented, recovered, found as expressed below:

**NOTE: Not more than 4 corners, all in the same town and range, may be recorded on this certificate.**

**A. Description of original monument and accessories and/or subsequent restoration:**

**GLO POST - NO EVIDENCE OF ORIGINAL CORNER FOUND**

**GLO ORIGINAL SURVEY PERFORMED BY JOSEPH FLETCHER UNDER CONTRACT DATED SEPT., 1816**

**PLATS**

- |             |   |                   |
|-------------|---|-------------------|
| L. 31 P. 18 | ROBERT M. GRINDLEY'S SUBDIVISION NO. 5          | AUGUST 8, 1914    |
| L. 34 P. 20 | BUCKINGHAM PARK SUBDIVISION                     | MARCH 15, 1916    |
| L. 49 P. 50 | PLYMOUTH-MONNIER HEIGHTS.SUB.                   | FEBRUARY 19, 1924 |
| L. 51 P. 39 | WARK-GIBBON'S PLYMOUTH-MONNIER ROAD SUBDIVISION | OCTOBER 16, 1924  |

**B. Description of corner evidence found and/or method applied in restoring or reestablishing corner:**

**NO EVIDENCE OF CORNER FOUND.  
 RE-ESTABLISHED CORNER BY USING CURB SPLITS WITH REFERENCE TO THE ABOVE LISTED PLATS.  
 VERIFIED LOCATION WITH FOUND IRONS AND SIDEWALK SPLITS.**

**FIELD MEASUREMENTS AND RECORDED DISTANCES**

C-12 TO C-13 2640.36' (M.)

**PLACED WAYNE COUNTY REMONUMENTATION MARKER AND ALUMINUM CAP #28408 ON 1/2" x 18" IRON WITHIN A MONUMENT BOX.**

**C. Description of monument for corner and accessories established to perpetuate locating the position of the corner:**

C-12 T.1S, R.11E. WAYNE COUNTY REMONUMENTATION MARKER AND ALUMINUM CAP #28408 ON 1/2" x 18" IRON IN A MONUMENT BOX


**WITNESSES**

- |          |        |  |
|----------|--------|--|
| AZ. 329° | 50.63' | SET PK W/TAG IN SOUTHWEST FACE OF UTILITY POLE |
| AZ. 38°  | 45.62' | SET PK W/TAG IN NORTH FACE OF UTILITY POLE     |
| AZ. 128° | 47.84' | SET PK W/TAG IN SOUTHWEST FACE OF UTILITY POLE |
| AZ. 220° | 46.24' | SET PK W/TAG IN WEST FACE OF UTILITY POLE      |

**THE SELECTED LOCATION FOR THIS PROPERTY CONTROLLING MONUMENT IS ACCEPTED AS A CAREFUL AND FAITHFUL DETERMINATION OF THE POSITION AS INDICATED.**

Signed by Steven E. Dunn  
 Surveyor's Michigan License No. 28408

Date DECEMBER 5, 1995

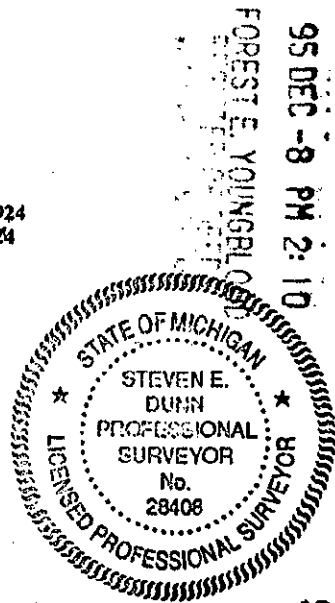

95 DEC -8 PM 2:10

95263069

4  
77  
nd.