

**SURVEY & REMONUMENTATION**

APR 05 1996

**LAND CORNER RECORDATION CERTIFICATE**  
Filing Requirement of Act 74, Mich. P.A. 1970

**LIBER 28452 PAGE 755**

For corners in

**WAYNE**

(County)

**COMMISSION**

Located In:

**GREENFIELD TWP  
(NOW CITY OF DETROIT)**

Corner Code #

- |                                    |   |    |   |     |      |
|------------------------------------|---|----|---|-----|------|
| 1. Public Land Survey              | T | 1S | R | 11E | C-13 |
|                                    | T |    | R |     |      |
|                                    | T |    | R |     |      |
|                                    | T |    | R |     |      |
| 2. Property Controlling in Section | S |    | T | R   |      |
|                                    | S |    | T | R   |      |
| 3. Miscellaneous Property in Sec.  | S |    | T | R   |      |
|                                    | S |    | T | R   |      |

Compliance with  
ACT 345, P.A. 1990

APPROVED ON: **DEC 5 1995** *ncd.*  
WAYNE COUNTY REMONUMENTATION  
PEER GROUP COMMITTEE

Register of Deeds Stamp & File Number

4. Lot No. \_\_\_\_\_, Recorded Plat \_\_\_\_\_  
5. Private Claims \_\_\_\_\_

|    | A  | B  | C  | D  | E  | F  | G | H | I | J | K | L | M |
|----|----|----|----|----|----|----|---|---|---|---|---|---|---|
| 2  | 8  | 6  | 4  | 3  | 2  | 1  |   |   |   |   |   |   |   |
| 3  |    |    |    |    |    |    |   |   |   |   |   |   |   |
| 4  | 7  | 8  | 9  | 10 | 11 | 12 |   |   |   |   |   |   |   |
| 5  |    |    |    |    |    |    |   |   |   |   |   |   |   |
| 6  | 18 | 17 | 16 | 15 | 14 | 13 |   |   |   |   |   |   |   |
| 7  |    |    |    |    |    |    |   |   |   |   |   |   |   |
| 8  | 19 | 20 | 21 | 22 | 23 | 24 |   |   |   |   |   |   |   |
| 9  |    |    |    |    |    |    |   |   |   |   |   |   |   |
| 10 | 30 | 29 | 28 | 27 | 26 | 25 |   |   |   |   |   |   |   |
| 11 |    |    |    |    |    |    |   |   |   |   |   |   |   |
| 12 | 31 | 32 | 33 | 34 | 35 | 36 |   |   |   |   |   |   |   |
| 13 |    |    |    |    |    |    |   |   |   |   |   |   |   |

I, STEVEN E. DUNN, in a field survey on OCTOBER 8, 19 95, do hereby certify that under requirements of P.A. 74, Michigan P.A. of 1970, the corner points mentioned in lines 1 and 2 above were in conformance with regulations and rules therefore as required in the current manual of survey instructions of the United States Department of the Interior, Bureau of Land Management or by a decree of a Court of Law and /or that the corner points mentioned in lines 3, 4 and 5 above were in conformance with the rules of the Michigan Board of Land Surveyors or by a Decree of a Court of Law; established, re-established, monumented, re-monumented, recovered, found as expressed below:

**NOTE: Not more than 4 corners, all in the same town and range, may be recorded on this certificate.**

A. Description of original monument and accessories and/or subsequent restoration:

GLO POST - NO EVIDENCE OF ORIGINAL CORNER FOUND

GLO ORIGINAL SURVEY PERFORMED BY JOSEPH FLETCHER UNDER CONTRACT DATED 3, SEPT. 1816

PLATS

L. 31 P. 13  
L. 54 P. 90  
L. 48 P. 58

ROBERT M GRINDLEY'S SUBDIVISION NO. 6 OF LITTLE FARMS  
GREENFIELD IMPROVEMENT SALES CO.'S GREENFIELD-MONNIER RE-SUB  
ROBERT OAKMAN LAND COMPANY'S AVIATION FIELD SUB. NO. 4.

AUGUST 6, 1914  
MAY 28, 1925  
DECEMBER 22, 1925

95263070

B. Description of corner evidence found and/or method applied in restoring or reestablishing corner:

E-13 T.1S, R.11E. COMMON TO E-1 T.2S, R.11E.


NO EVIDENCE OF CORNER FOUND

RE-ESTABLISHED NORTH LINE OF JOY ROAD USING FOUND IRONS WITH REFERENCE TO "ROBERT OAKMANS LAND COMPANY SUB" L. 52 P. 86. RE-ESTABLISHED EAST LINE OF WYOMING USING FOUND IRONS WITH REFERENCE TO "ROBERT OAKMAN'S LAND COMPANY SUB" L. 43 P. 95. VERIFIED LOCATION WITH STONE CURB SPLITS AND SIDEWALK SPLITS.

FIELD MEASUREMENTS AND RECORDED DISTANCES

C-13 TO B-13 2635.43' (M.)  
C-13 TO C-12 2640.36' (M.)

PLACED WAYNE COUNTY REMONUMENTATION MARKER AND ALUMINUM CAP #28408 ON 1/2" x 18" IRON WITHIN A MONUMENT BOX.

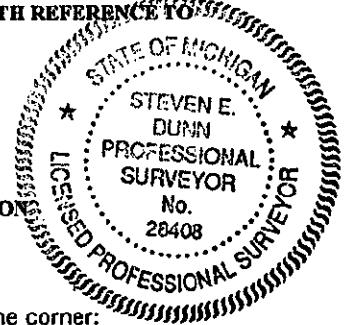

C. Description of monument for corner and accessories established to perpetuate locating the position of the corner:

E-13 T.1S., R.11E. WAYNE COUNTY REMONUMENTATION MARKER AND ALUMINUM CAP #28408 ON 1/2" x 18" ROD IN MONUMENT BOX.

WITNESSES

- |         |        |  |
|---------|--------|--|
| AZ 318° | 97.01' | SET PK NAIL AND W.C.R. TAG IN SOUTHEAST CORNER OF BUILDING #8801 |
| AZ 213° | 50.11' | SET PK NAIL AND W.C.R. TAG IN WEST FACE OF UTILITY POLE          |
| AZ 295° | 68.34' | SET PK NAIL AND W.C.R. TAG IN SOUTHWEST FACE OF UTILITY POLE     |
| AZ 67°  | 63.03' | SET PK NAIL AND W.C.R. TAG IN NORTHWEST FACE OF UTILITY POLE     |

THE SELECTED LOCATION IS FOR THIS PROPERTY CONTROLLING MONUMENT IS ACCEPTED AS A CAREFUL AND FAITHFUL DETERMINATION OF THE POSITION INDICATED.

Signed by Steven E. Dunn

Date DECEMBER 5, 1995

Surveyor's Michigan License No. 28408

*4  
7 D  
7110.*